

Index of Sheets  
(See Sheet NO. 1A)

STATE OF TENNESSEE  
DEPARTMENT OF TRANSPORTATION  
BUREAU OF ENGINEERING

CUMBERLAND COUNTY

S.R. 28 (U.S. 127) FROM: S.R. 68  
TO: CLEVELAND STREET IN CROSSVILLE

CONSTRUCTION

GRADE, BASE, DRAIN, PAVING SIGNING AND MARKING

STATE HIGHWAY NO. 28 F.A.H.S. NO. 127

WATER  
SEWER  
PLANS




CUMBERLAND COUNTY  
S.R. 28




S.R. 28  
END PROJECT NO. 18006-3210-04  
STA. 21+605.000 CONST.

ADJACENT PROJECT S.R. 392  
SEE PROJECT NO. 18083-3209-04

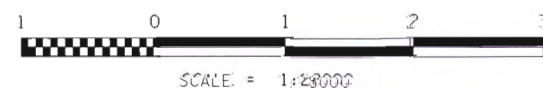

S.R. 28  
BEGIN PROJECT NO. 18006-3210-04  
STA. 15+700.00 CONST.

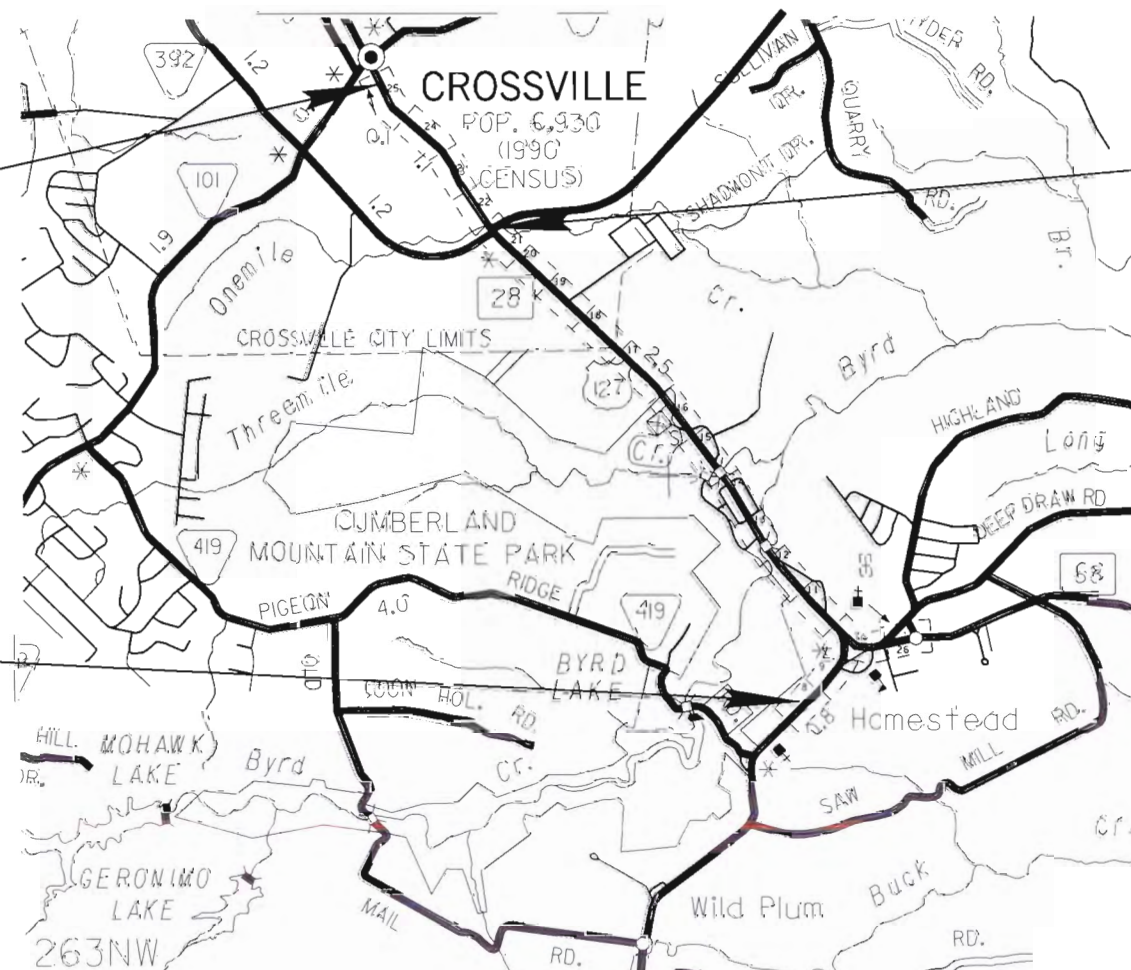

SCALE = 1:28000

SPECIAL NOTES

PROPOSALS MAY BE REJECTED BY THE COMMISSIONER IF ANY OF THE UNIT PRICES CONTAINED THEREIN ARE OBVIOUSLY UNBALANCED, EITHER EXCESSIVE OR BELOW THE REASONABLE COST ANALYSIS VALUE.

THIS PROJECT TO BE CONSTRUCTED UNDER THE STANDARD SPECIFICATIONS OF THE TENNESSEE DEPARTMENT OF TRANSPORTATION DATED MARCH 1, 2006 AND ADDITIONAL SPECIFICATIONS AND SPECIAL PROVISIONS CONTAINED IN THE PLANS AND IN THE PROPOSAL CONTRACT.

TDOT ROAD SP. SV. 2 ROBERT RODGERS

DESIGNER JAMES A. BALL JR CHECKED BY

P.E. NO. 18006-1209-04

PIN NO. 101044.00

ROADWAY LENGTH 5.905 km  
BRIDGE LENGTH 0.000 km  
BOX BRIDGE LENGTH 0.000 km  
PROJECT LENGTH 5.905 km

FOR  
CONST.  
FIELD  
REVIEW  
ONLY

NO EXCLUSIONS  
NO EQUATIONS



APPROVED: Paul D. Rogers  
CHIEF ENGINEER

DATE:


APPROVED: David F. Neely  
COMMISSIONER

| TRAFFIC DATA |         |
|--------------|---------|
| ADT (2001)   | 12,310  |
| ADT (2021)   | 21,050  |
| DHV (2021)   | 2,105   |
| D            | 65 - 35 |
| T (ADT)      | 10 %    |
| T (DHV)      | 7 %     |
| V            | TO km/h |

U.S. DEPARTMENT OF TRANSPORTATION  
FEDERAL HIGHWAY ADMINISTRATION

APPROVED: \_\_\_\_\_  
DIVISION ADMINISTRATOR DATE

| TYPE   | YEAR | PROJECT NO.   | SHEET NO. |
|--------|------|---------------|-----------|
| R.O.W. | 2001 | 18006-2210-04 | U1-1      |
|        |      |               |           |
|        |      |               |           |

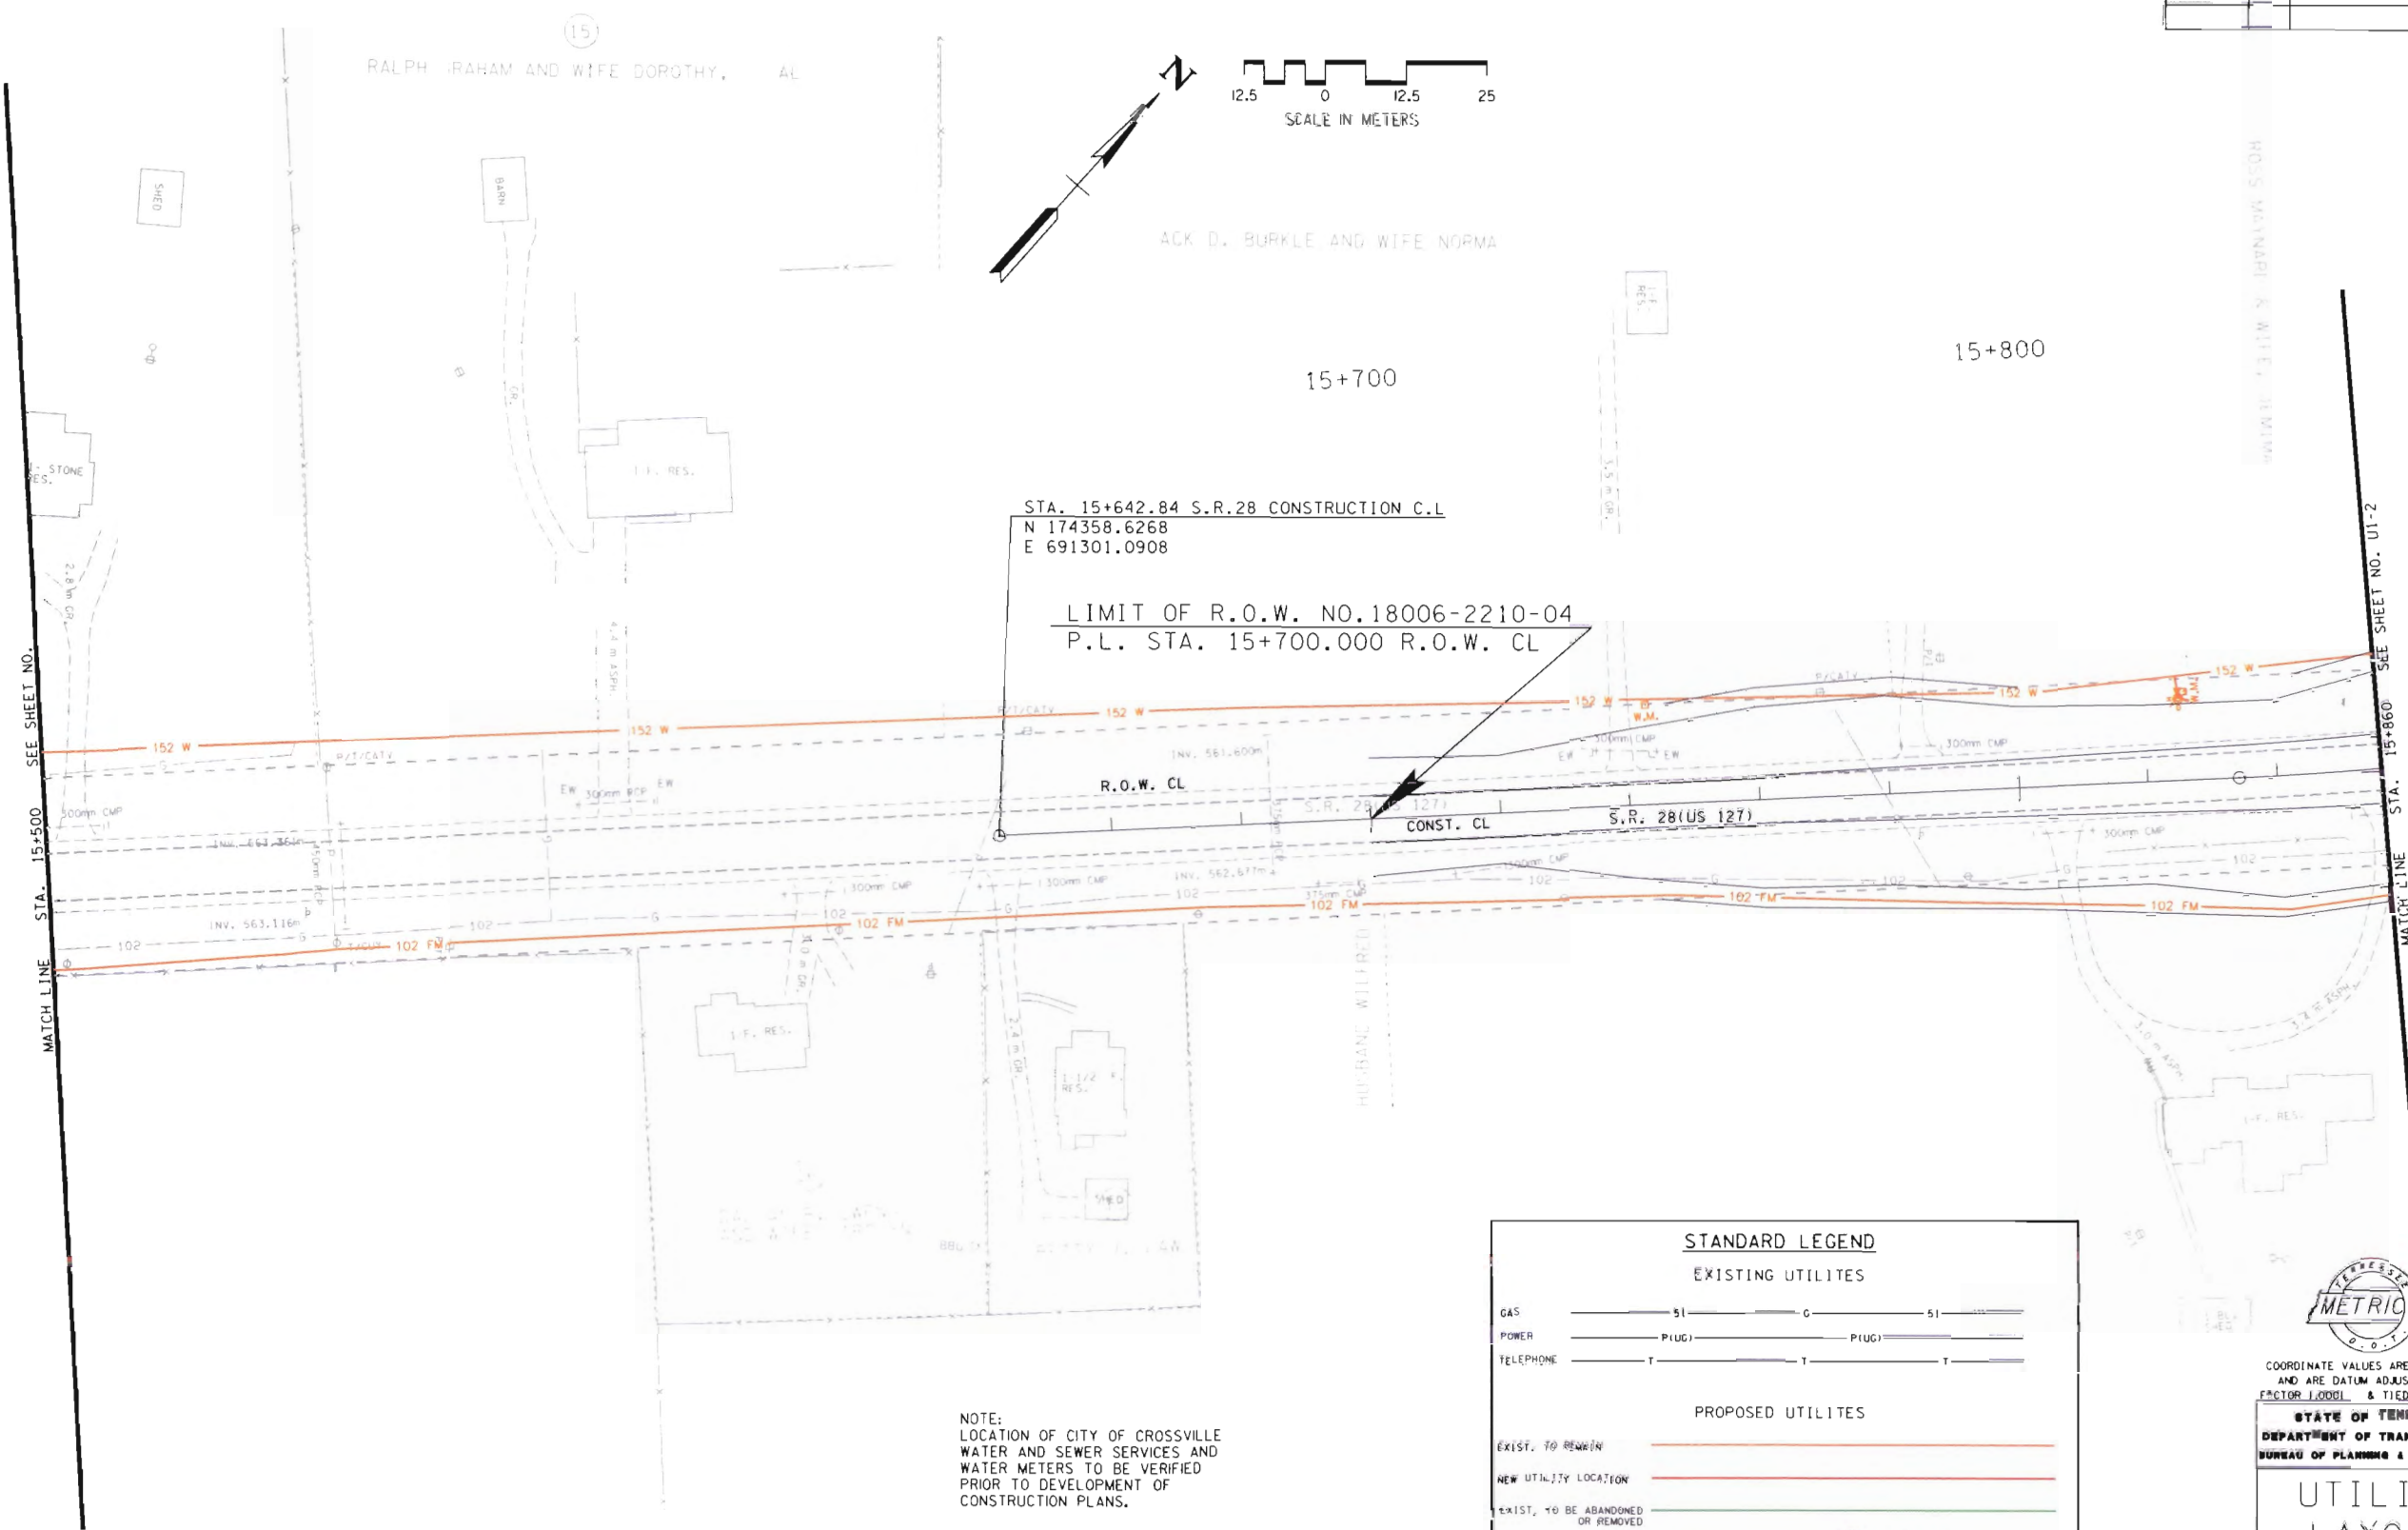

STA. 15+642.84 S.R.28 CONSTRUCTION C.L  
 N 174358.6268  
 E 691301.0908

LIMIT OF R.O.W. NO.18006-2210-04  
 P.L. STA. 15+700.000 R.O.W. CL

NOTE:  
 LOCATION OF CITY OF CROSSVILLE  
 WATER AND SEWER SERVICES AND  
 WATER METERS TO BE VERIFIED  
 PRIOR TO DEVELOPMENT OF  
 CONSTRUCTION PLANS.

STANDARD LEGEND

EXISTING UTILITES

GAS

POWER

TELEPHONE

51

P(UG)

T

C

P(UG)

T

51

PROPOSED UTILITES

EXIST. TO REMAIN

NEW UTILITY LOCATION

EXIST. TO BE ABANDONED OR REMOVED

REMOVE

ABANDON

TENNESSEE

METRIC

D.O.T.

COORDINATE VALUES ARE NAD(83)1995

AND ARE DATUM ADJUSTED BY THE

FACTOR 1.0001 & TIED TO THE TGRN.

STATE OF TENNESSEE

DEPARTMENT OF TRANSPORTATION

BUREAU OF PLANNING & DEVELOPMENT

UTILITY LAYOUT

STA. 15+500 TO STA. 15+860


S.R. 28 / U.S. 127



REVISION: 05/01/06 MODIFIED  
PROP. R.O.W. DUE TO NEW  
INTERSECTION DESIGN AND  
NEW PROJECT LIMITS.

| TYPE   | YEAR | PROJECT NO.   | SHEET NO. |
|--------|------|---------------|-----------|
| R.O.W. | 2001 | 18006-2210-04 | U1-2      |
|        |      |               |           |
|        |      |               |           |

REVISION: 02/26/07 ADJUSTED BUS.  
ENT. RT. STA. 16+058.22. CHANGED  
PROPOSED R.O.W. TO CONST. AND SLOPE  
ESMT. ON TRACT NO. 26. DELETED  
DRAINAGE ESMT LT. AND ADDED RT.  
RT. STA. 15+980. LINED THROUGH TRACT  
NO. 20 AND 24S. ADDED TRACT NO. 20S.  
CORRECTED PRESENT R.O.W. RT. FROM  
STA. 16+085.898 TO 16+118.206.

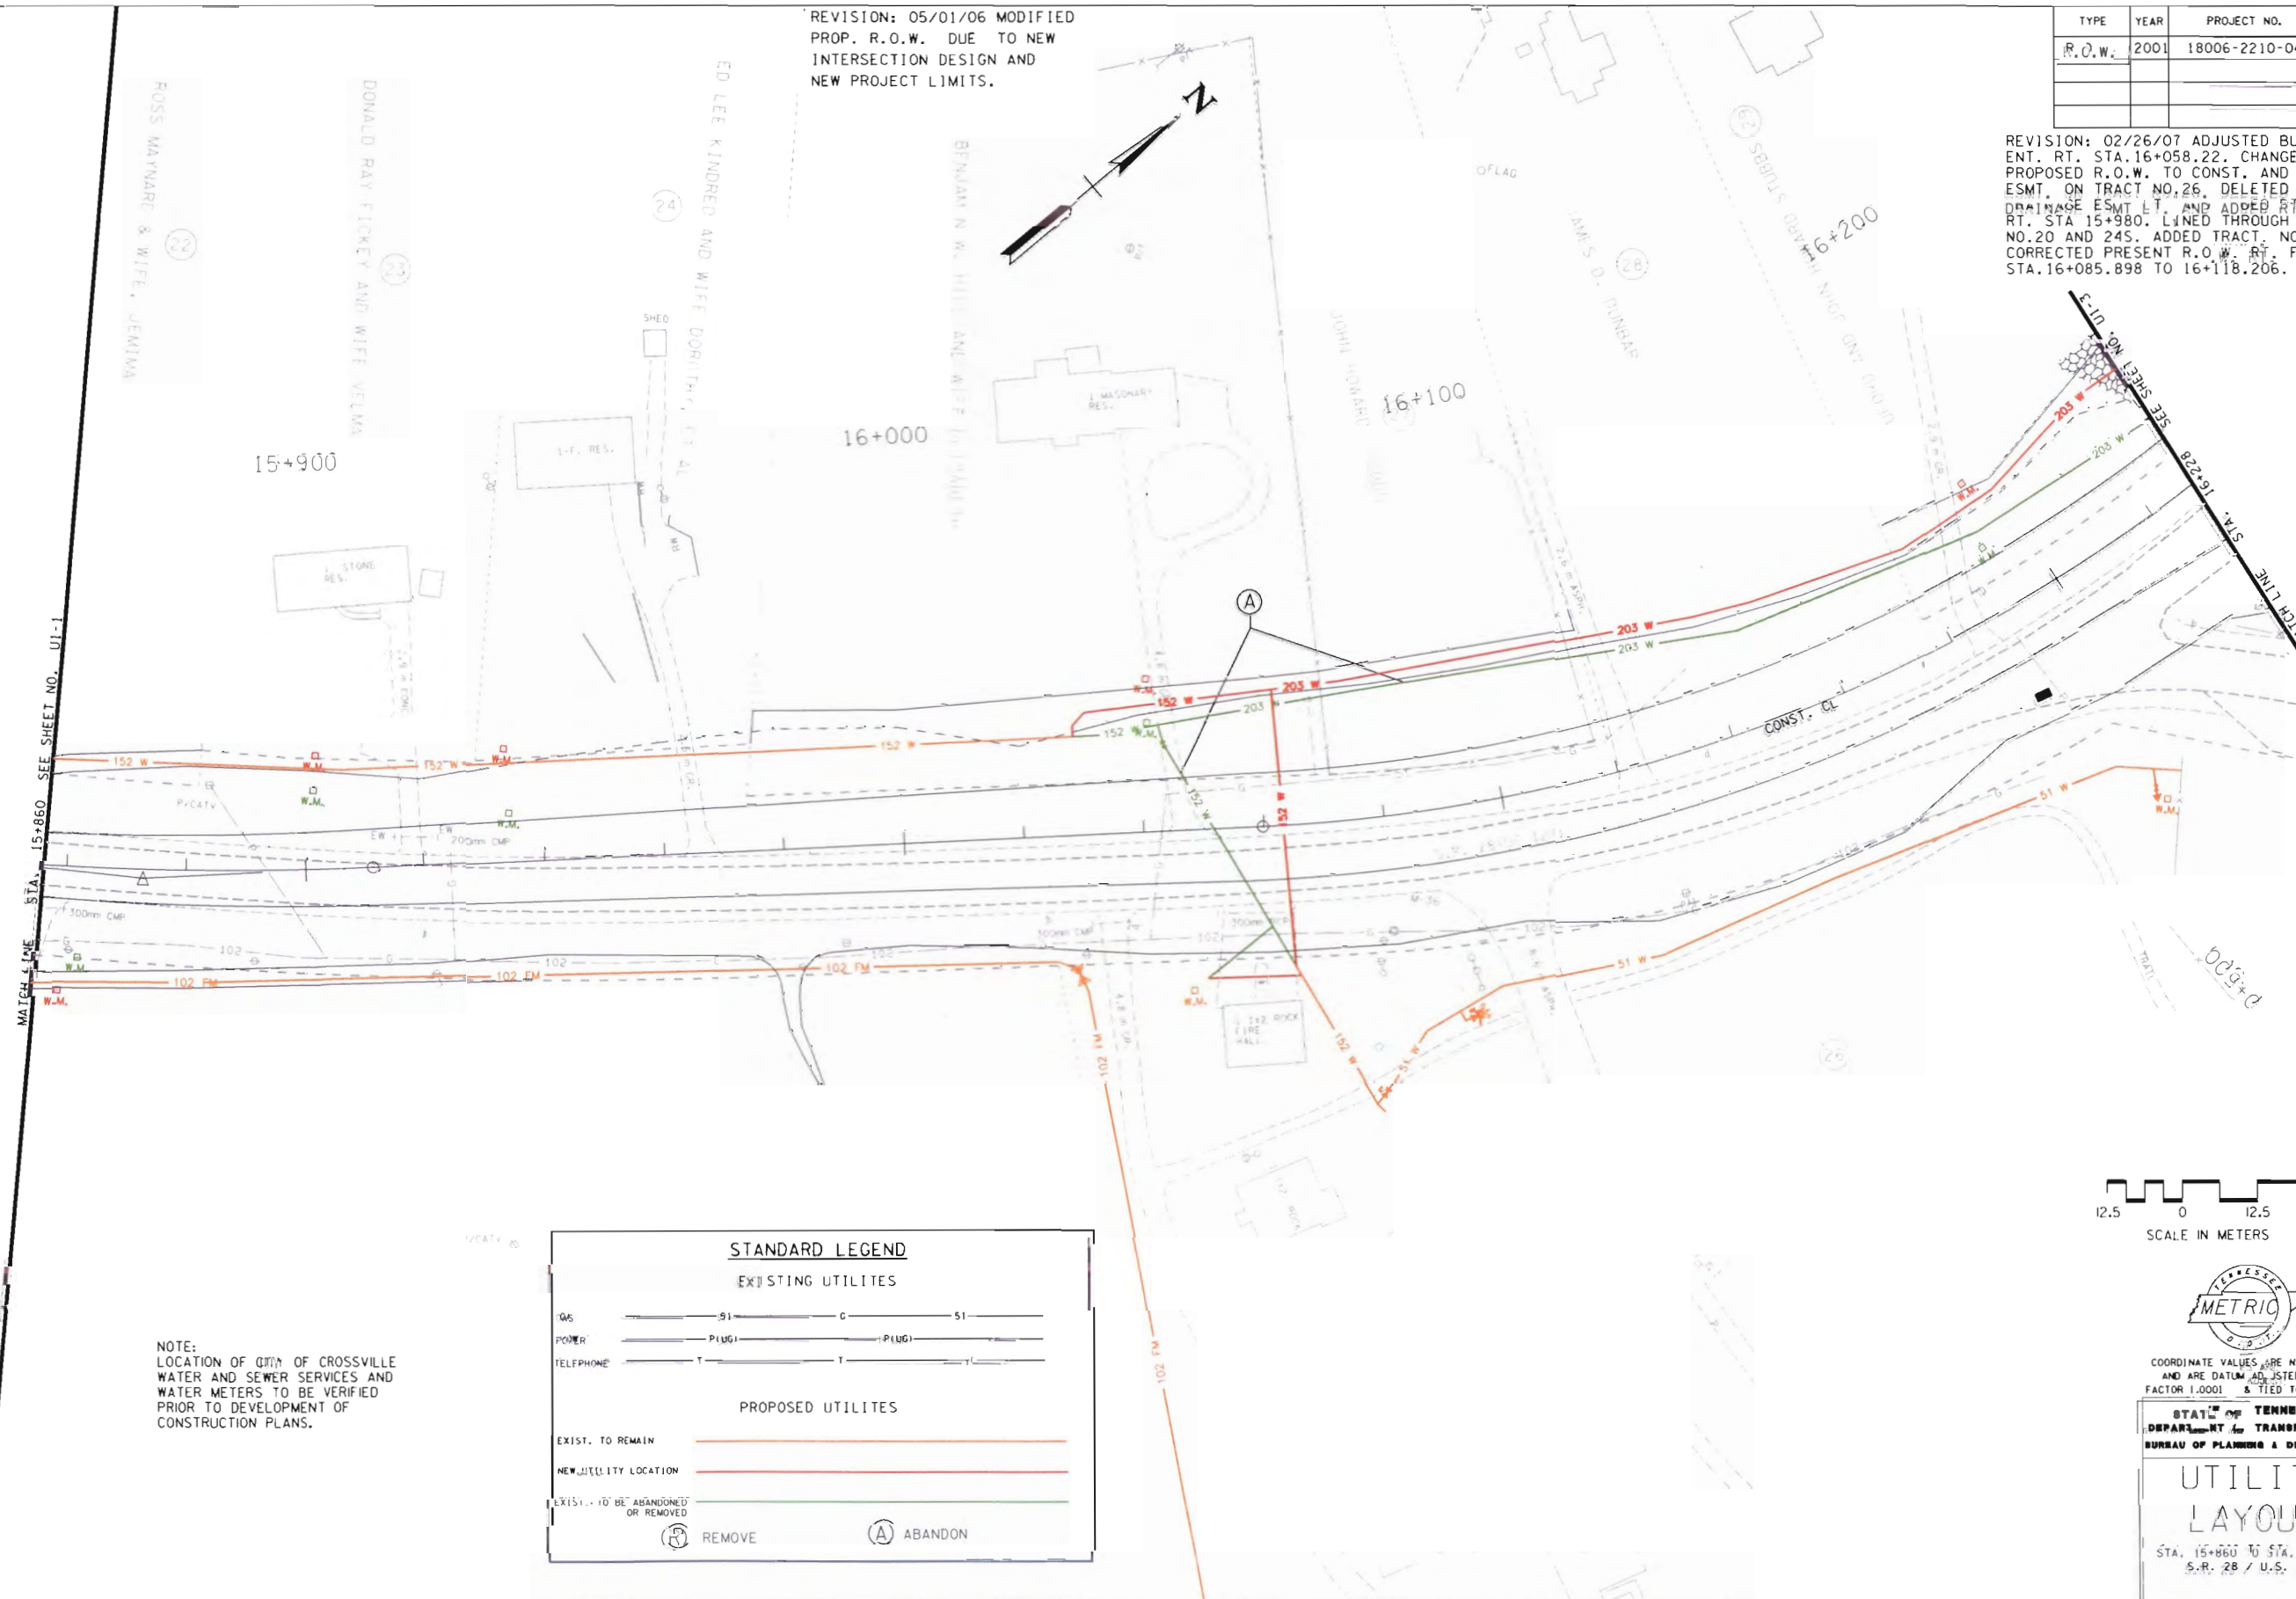

NOTE:  
LOCATION OF QTY OF CROSSVILLE  
WATER AND SEWER SERVICES AND  
WATER METERS TO BE VERIFIED  
PRIOR TO DEVELOPMENT OF  
CONSTRUCTION PLANS.

**STANDARD LEGEND**

**EXISTING UTILITIES**

WATER ———— S1 ———— C ———— S1

POWER ———— P (UG) ———— P (UG)

TELEPHONE ———— T ———— T

**PROPOSED UTILITIES**

EXIST. TO REMAIN ————

NEW UTILITY LOCATION ————

EXIST. TO BE ABANDONED OR REMOVED ————

(R) REMOVE      (A) ABANDON



**TENNESSEE METRIC**

COORDINATE VALUES ARE NAD 83 (1995)  
AND ARE DATUM ADJUSTED BY THE  
FACTOR 1.0001 & TIED TO THE TGN.

**STATE OF TENNESSEE**  
**DEPARTMENT OF TRANSPORTATION**  
**BUREAU OF PLANNING & DEVELOPMENT**


**UTILITY LAYOUT**

STA. 15+860 TO STA. 16+220  
S.R. 28 / U.S. 127



TENNESSEE D.O.T.  
DESIGN DIVISION  
FILE NO.

| TYPE   | YEAR | PROJECT NO.   | SHEET NO. |
|--------|------|---------------|-----------|
| R.O.W. | 2001 | 18006-2210-04 | UI-3      |
|        |      |               |           |
|        |      |               |           |

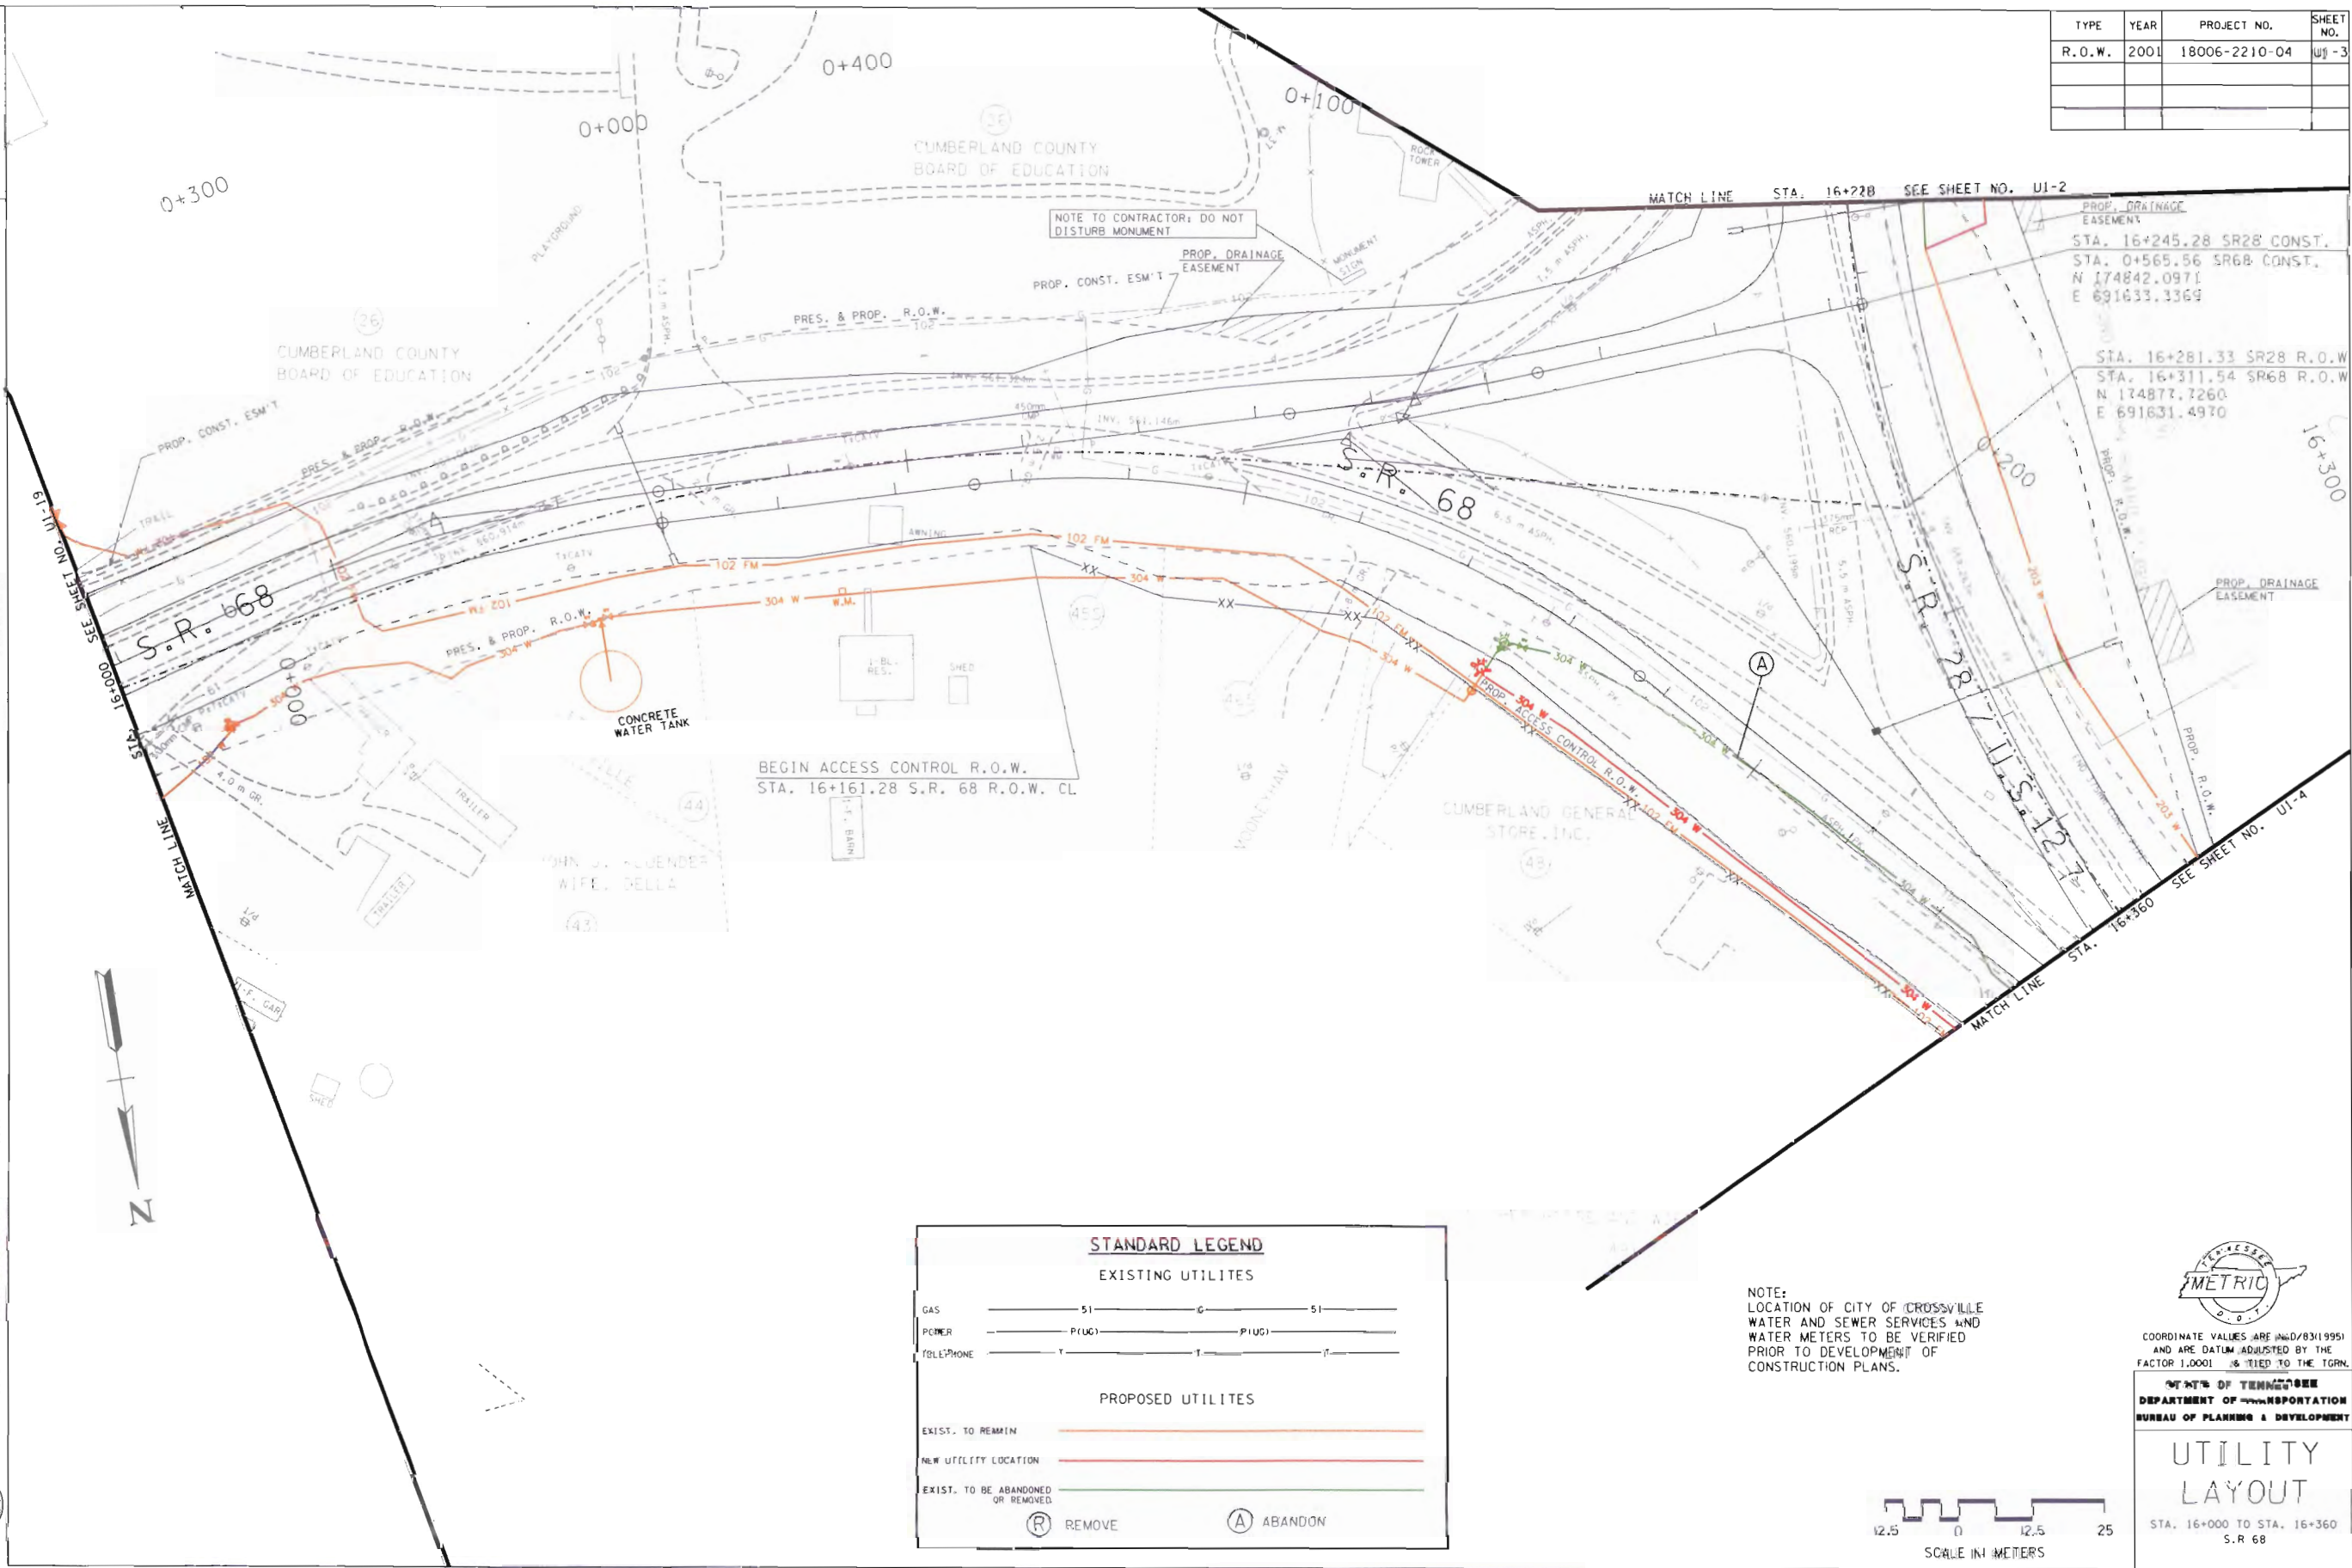

**STANDARD LEGEND**

EXISTING UTILITIES

GAS ——— S1 ——— G ——— S1 ———

POWER ——— P(UG) ——— P(UG) ———

TELEPHONE ——— T ——— T ———

PROPOSED UTILITIES

EXIST. TO REMAIN ———

NEW UTILITY LOCATION ———

EXIST. TO BE ABANDONED OR REMOVED ———

(R) REMOVE (A) ABANDON

NOTE:  
LOCATION OF CITY OF CROSSVILLE  
WATER AND SEWER SERVICES AND  
WATER METERS TO BE VERIFIED  
PRIOR TO DEVELOPMENT OF  
CONSTRUCTION PLANS.

SCALE IN METERS

12.5 0 12.5 25

UTILITY LAYOUT


STA. 16+000 TO STA. 16+360  
S.R. 68



|                  |
|------------------|
| TENNESSEE D.O.T. |
| DESIGN DIVISION  |
| FILE NO.         |

| TYPE   | YEAR | PROJECT NO.   | SHEET NO. |
|--------|------|---------------|-----------|
| R.O.W. | 2001 | 18006-2210-04 | U1-4      |

REVISION: 01/06/03 ADDED 8m BUS. ENT. AT STA. 16+410.00 LT.

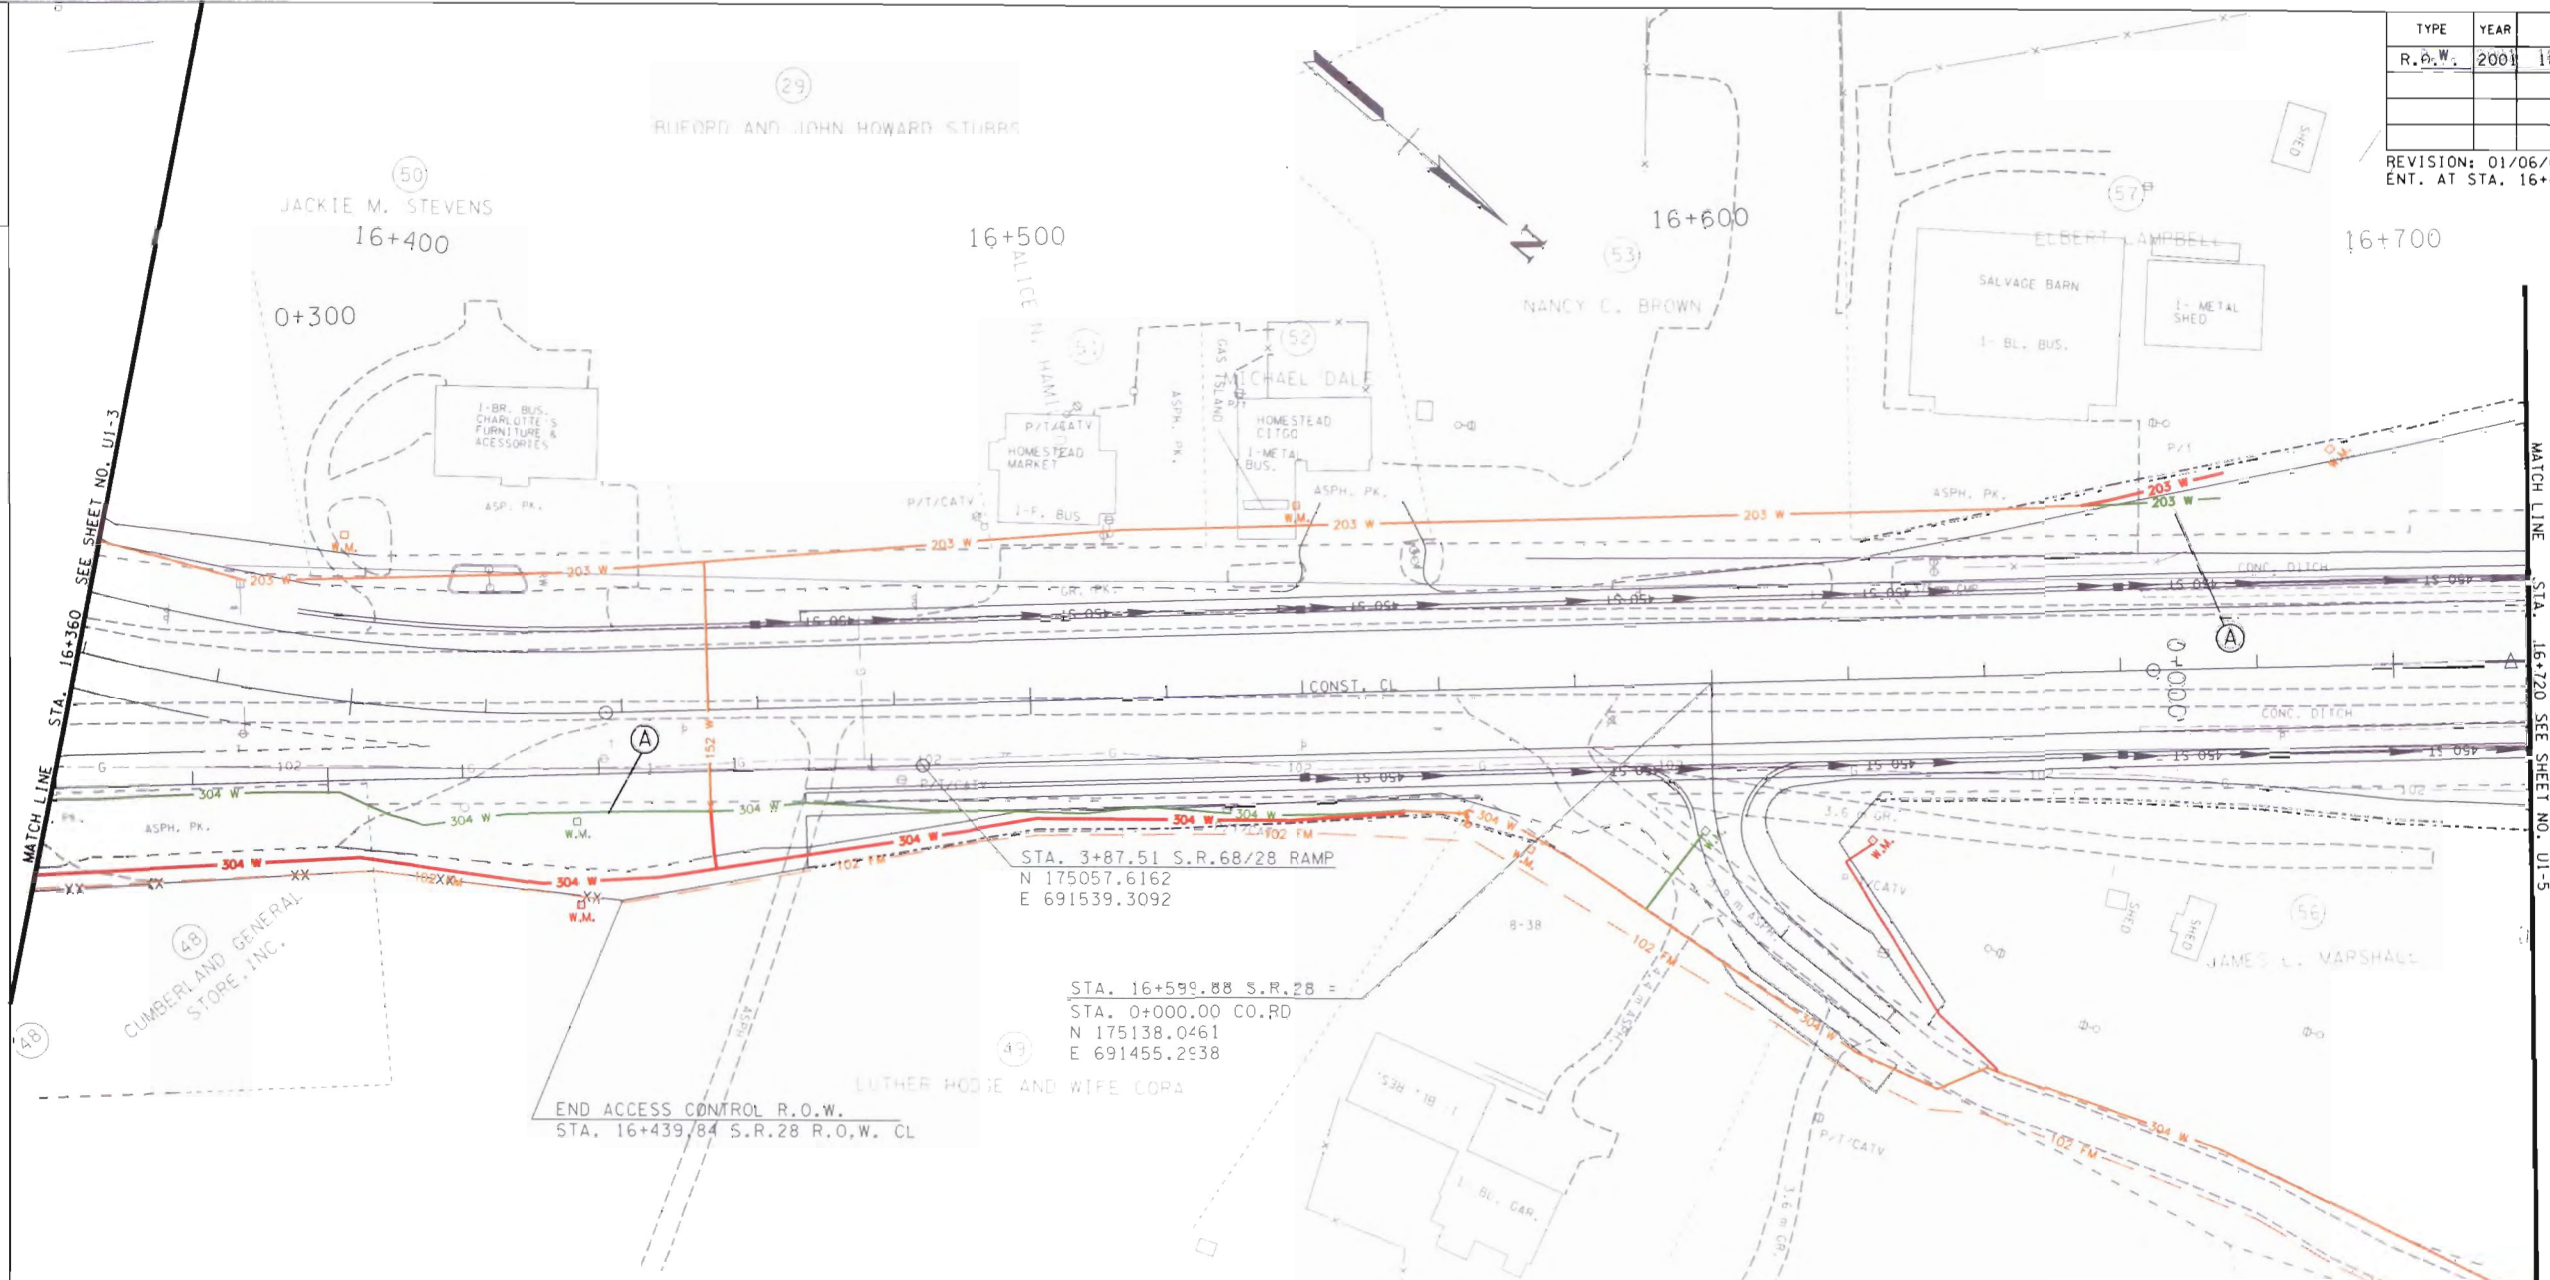

| STANDARD LEGEND                   |                 |
|-----------------------------------|-----------------|
| EXISTING UTILITES                 |                 |
| GAS                               | SI ——— C ——— SI |
| POWER                             | P100 ——— P100   |
| TELEPHONE                         | T ——— T         |
| PROPOSED UTILITES                 |                 |
| EXIST. TO REMAIN                  | —————           |
| NEW UTILITY LOCATION              | —————           |
| EXIST. TO BE ABANDONED OR REMOVED | —————           |
| (R) REMOVE                        | (A) ABANDON     |

NOTE:  
LOCATION OF CITY OF CROSSVILLE  
WATER AND SEWER SERVICES AND  
WATER METERS TO BE VERIFIED  
PRIOR TO DEVELOPMENT OF  
CONSTRUCTION PLANS.

NOTE: WATER LINES INSTALLED IN THE 1940'S  
NO RECORDS AVAILABLE. MANY LINES  
ABANDONED, COULD NOT BE LOCATED.




COORDINATE VALUES ARE NAD(83) (95)  
AND ARE DATUM ADJUSTED BY THE  
FACTOR 1.0001 AND TIED TO THE TGRN.

STATE OF TENNESSEE  
DEPARTMENT OF TRANSPORTATION  
BUREAU OF PLANNING & DEVELOPMENT



# UTILITY LAYOUT

STA. 16+360 TO STA. 16+720  
S.R. 28 / U.S. 127

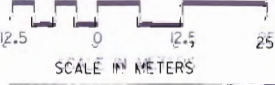



| TYPE   | YEAR | PROJECT NO.   | SHEET NO. |
|--------|------|---------------|-----------|
| R.O.W. | 2001 | 18006-2210-04 | U1-5      |
|        |      |               |           |
|        |      |               |           |

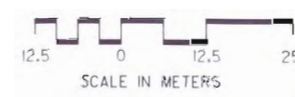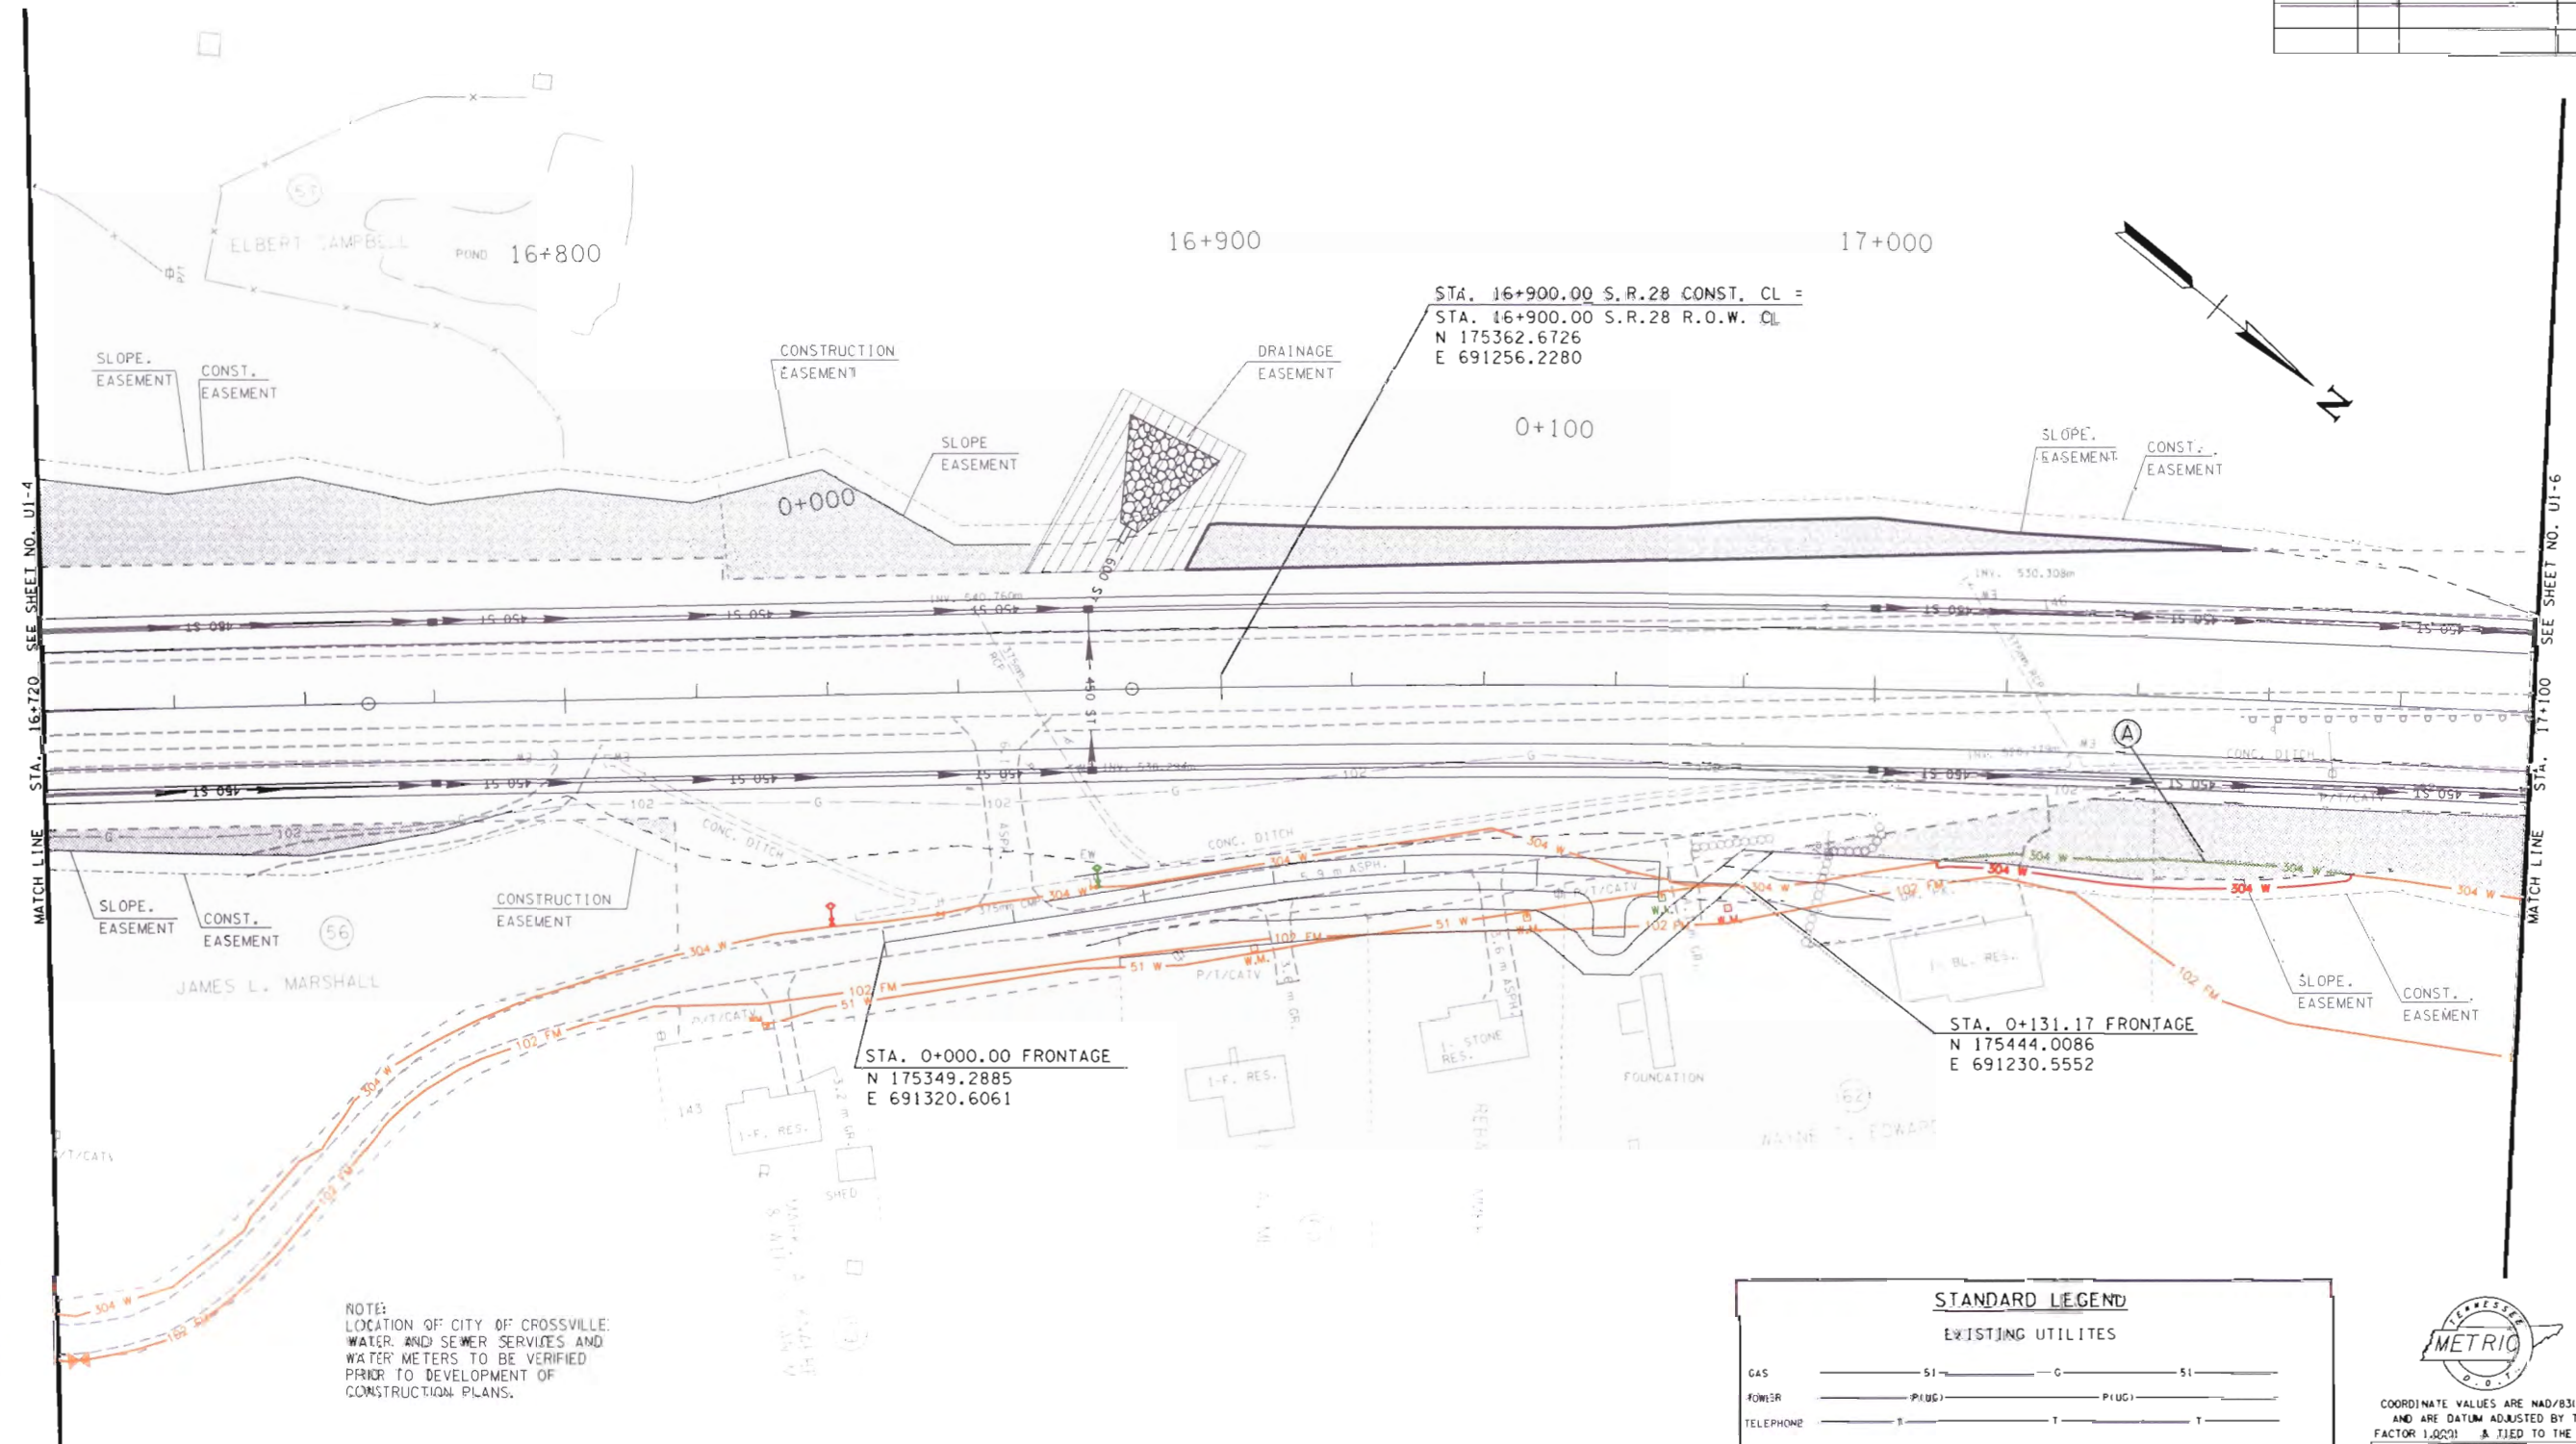

**STANDARD LEGEND**

**EXISTING UTILITIES**

GAS ——— S1 ——— G ——— S1 ———

POWER ——— (PIUG) ——— (PIUG) ———

TELEPHONE ——— T ——— T ——— T ———

**PROPOSED UTILITIES**

EXIST. TO REMAIN ———

NEW UTILITY LOCATION ———

EXIST. TO BE ABANDONED OR REMOVED ———

(R) REMOVE (A) ABANDON

**TENNESSEE METRIC**

COORDINATE VALUES ARE NAD(83)1995  
AND ARE DATUM ADJUSTED BY THE  
FACTOR 1.0001 & TIED TO THE CORN.

**STATE OF TENNESSEE**  
**DEPARTMENT OF TRANSPORTATION**  
**BUREAU OF PLANNING & DEVELOPMENT**

**UTILITY LAYOUT**

STA. 16+720 TO STA. 17+100  
S.R. 28 / U.S. 127




TENNESSEE D.O.T.  
DESIGN DIVISION  
FILE NO.

REVISION: 05/01/06 MODIFIED  
PROP. R.O.W. DUE TO NEW  
INTERSECTION DESIGN AND  
NEW PROJECT LIMITS.

REVISION 4/10/02: DELETED PROPERTY OWNERS  
ADDRESSES FROM TRACTS 58, 63, & 64.

| TYPE   | YEAR | PROJECT NO.   | SHEET NO. |
|--------|------|---------------|-----------|
| R.O.W. | 2001 | 18006-2210-04 | U1-6      |
|        |      |               |           |
|        |      |               |           |

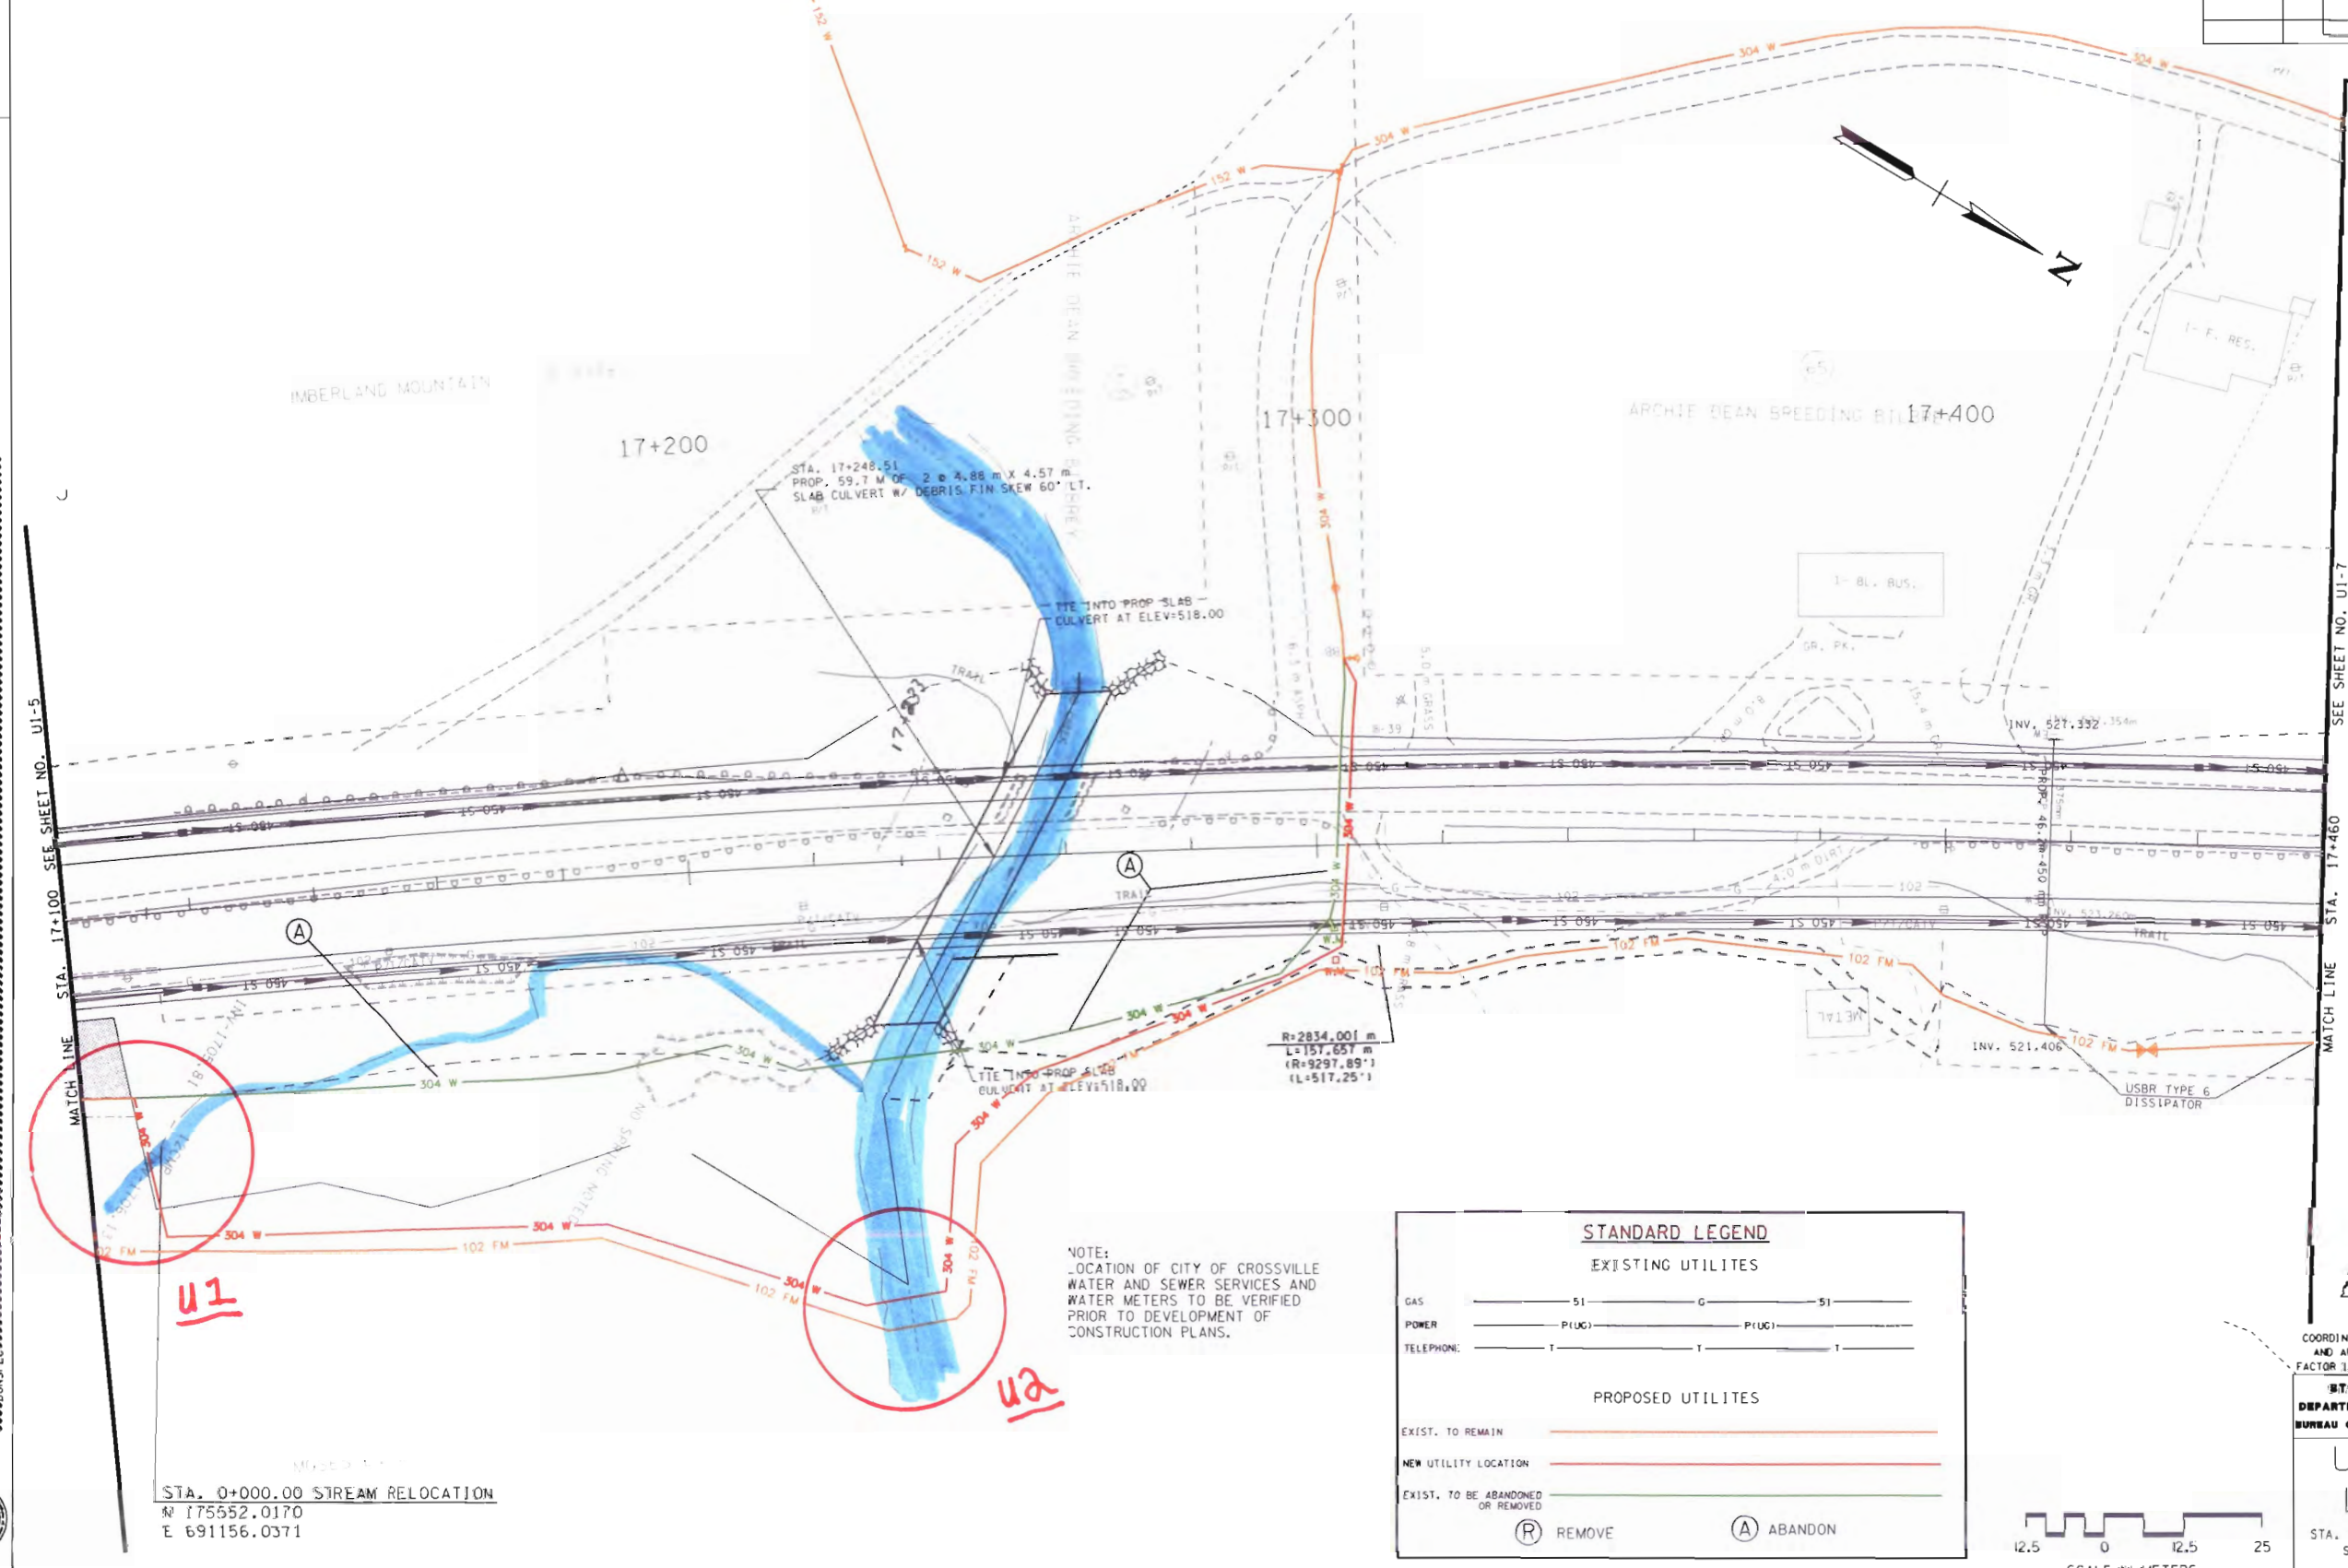

STA. 0+000.00 STREAM RELOCATION  
N 175552.0170  
E 691156.0371

NOTE:  
LOCATION OF CITY OF CROSSVILLE  
WATER AND SEWER SERVICES AND  
WATER METERS TO BE VERIFIED  
PRIOR TO DEVELOPMENT OF  
CONSTRUCTION PLANS.

**STANDARD LEGEND**

**EXISTING UTILITIES**

GAS: ———— S1 ———— G ———— S1 ————

POWER: ———— P(U) ———— P(U) ————

TELEPHONE: ———— T ———— T ————

**PROPOSED UTILITIES**

EXIST. TO REMAIN: ————

NEW UTILITY LOCATION: ————

EXIST. TO BE ABANDONED OR REMOVED: ————

(R) REMOVE (A) ABANDON

12.5 0 12.5 25  
SCALE IN FEET / METERS

COORDINATE VALUES ARE NAD(83) 1995  
AND ARE DATUM ADJUSTED BY THE  
FACTOR 1.0001 & TIED TO THE TGRN.

STATE OF TENNESSEE  
DEPARTMENT OF TRANSPORTATION  
BUREAU OF PLANNING & DEVELOPMENT

**UTILITY LAYOUT**

STA. 17+100 TO STA. 17+460  
S.R. 28 / U.S. 127




|                  |
|------------------|
| TENNESSEE D.O.T. |
| DESIGN DIVISION  |
| FILE NO.         |

REVISION: 02/26/07 ADDED FIELD ENTRANCE  
RT. STA. 17+500.

| TYPE   | YEAR | PROJECT NO.   | SHEET NO. |
|--------|------|---------------|-----------|
| R.O.W. | 2001 | 18006-2210-04 | U1-7      |
|        |      |               |           |
|        |      |               |           |

REVISION: 01/06/03 DELETED "ROBERT TOLLETT" FROM PROPERTY OWNERS NAME FOR TRACT NO. 70. CHANGED PROPERTY OWNERS NAME, DEED BOOK AND PAGE ON TRACT NO. 77. DELETED 6.0m BUS ENT. AT STA. 17+809.5 RT. ADDED 6m BUS. ENT. AT STA. 17+710.000 RT. ADDED 6m BUS. ENT. AT STA. 17+798 RT. DELETED 3.0m PVT. ENT. AT STA. 17+824 RT.

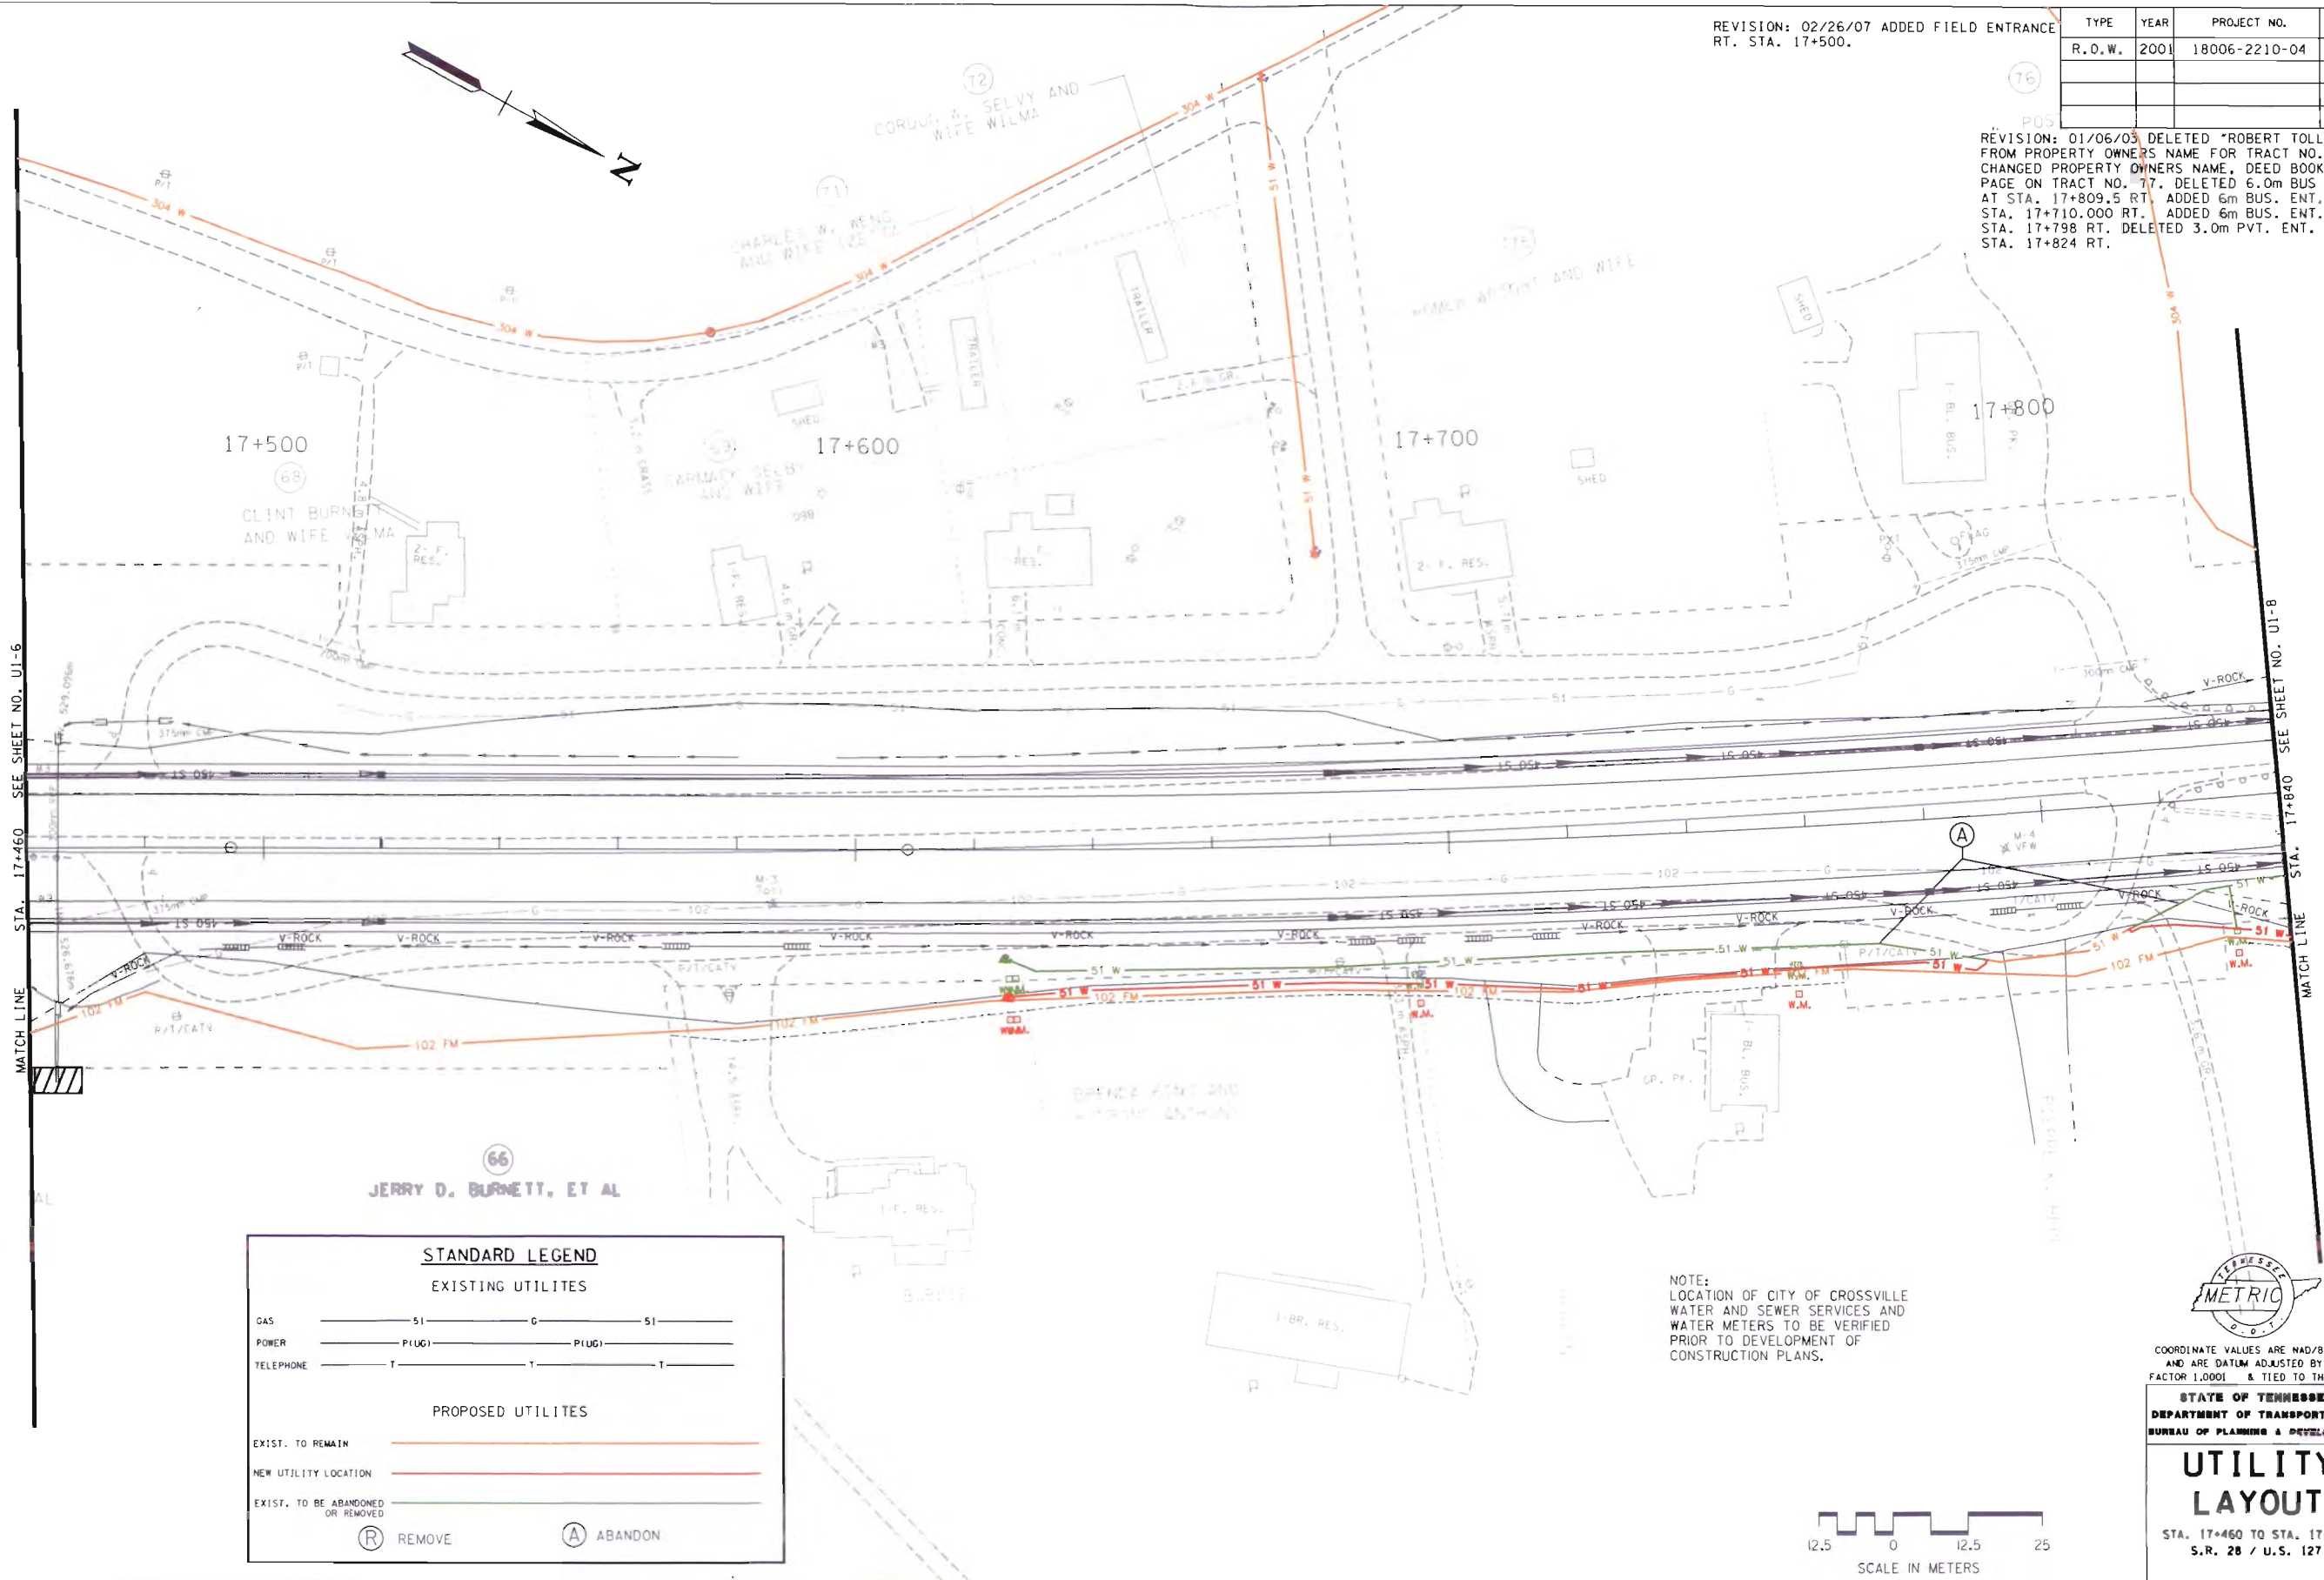

### STANDARD LEGEND

#### EXISTING UTILITES

GAS ———— 51 ———— G ———— 51 ————  
POWER ———— P(UG) ———— P(UG) ————  
TELEPHONE ———— T ———— T ————

#### PROPOSED UTILITES

EXIST. TO REMAIN ————  
NEW UTILITY LOCATION ————  
EXIST. TO BE ABANDONED OR REMOVED ————  
(R) REMOVE (A) ABANDON

NOTE:  
LOCATION OF CITY OF CROSSVILLE  
WATER AND SEWER SERVICES AND  
WATER METERS TO BE VERIFIED  
PRIOR TO DEVELOPMENT OF  
CONSTRUCTION PLANS.

12.5 0 12.5 25  
SCALE IN METERS



COORDINATE VALUES ARE NAD(83) 1995  
AND ARE DATUM ADJUSTED BY THE  
FACTOR 1.0001 & TIED TO THE TORN.

STATE OF TENNESSEE  
DEPARTMENT OF TRANSPORTATION  
BUREAU OF PLANNING & DEVELOPMENT

## UTILITY LAYOUT


STA. 17+460 TO STA. 17+840  
S.R. 28 / U.S. 127



TENNESSEE D.O.T.  
DESIGN DIVISION  
FILE NO.

REVISION 4/10/02: ADDED CLASS "B" RIP-RAP TO THE END OF BOX CULVERT AT STA. 17+887.6.  
REVISION: 01/06/03 CHANGED PROPERTY OWNERS NAME, DEED BOOK AND PAGE ON TRACT NO. 77.  
REVISION: 11/10/06 CHANGED EASEMENT LABEL FROM SLOPE EASEMENT TO DRAINAGE EASEMENT.

| TYPE   | YEAR | PROJECT NO.   | SHEET NO. |
|--------|------|---------------|-----------|
| R.O.W. | 2001 | 18006-2210-04 | U1-8      |
|        |      |               |           |
|        |      |               |           |

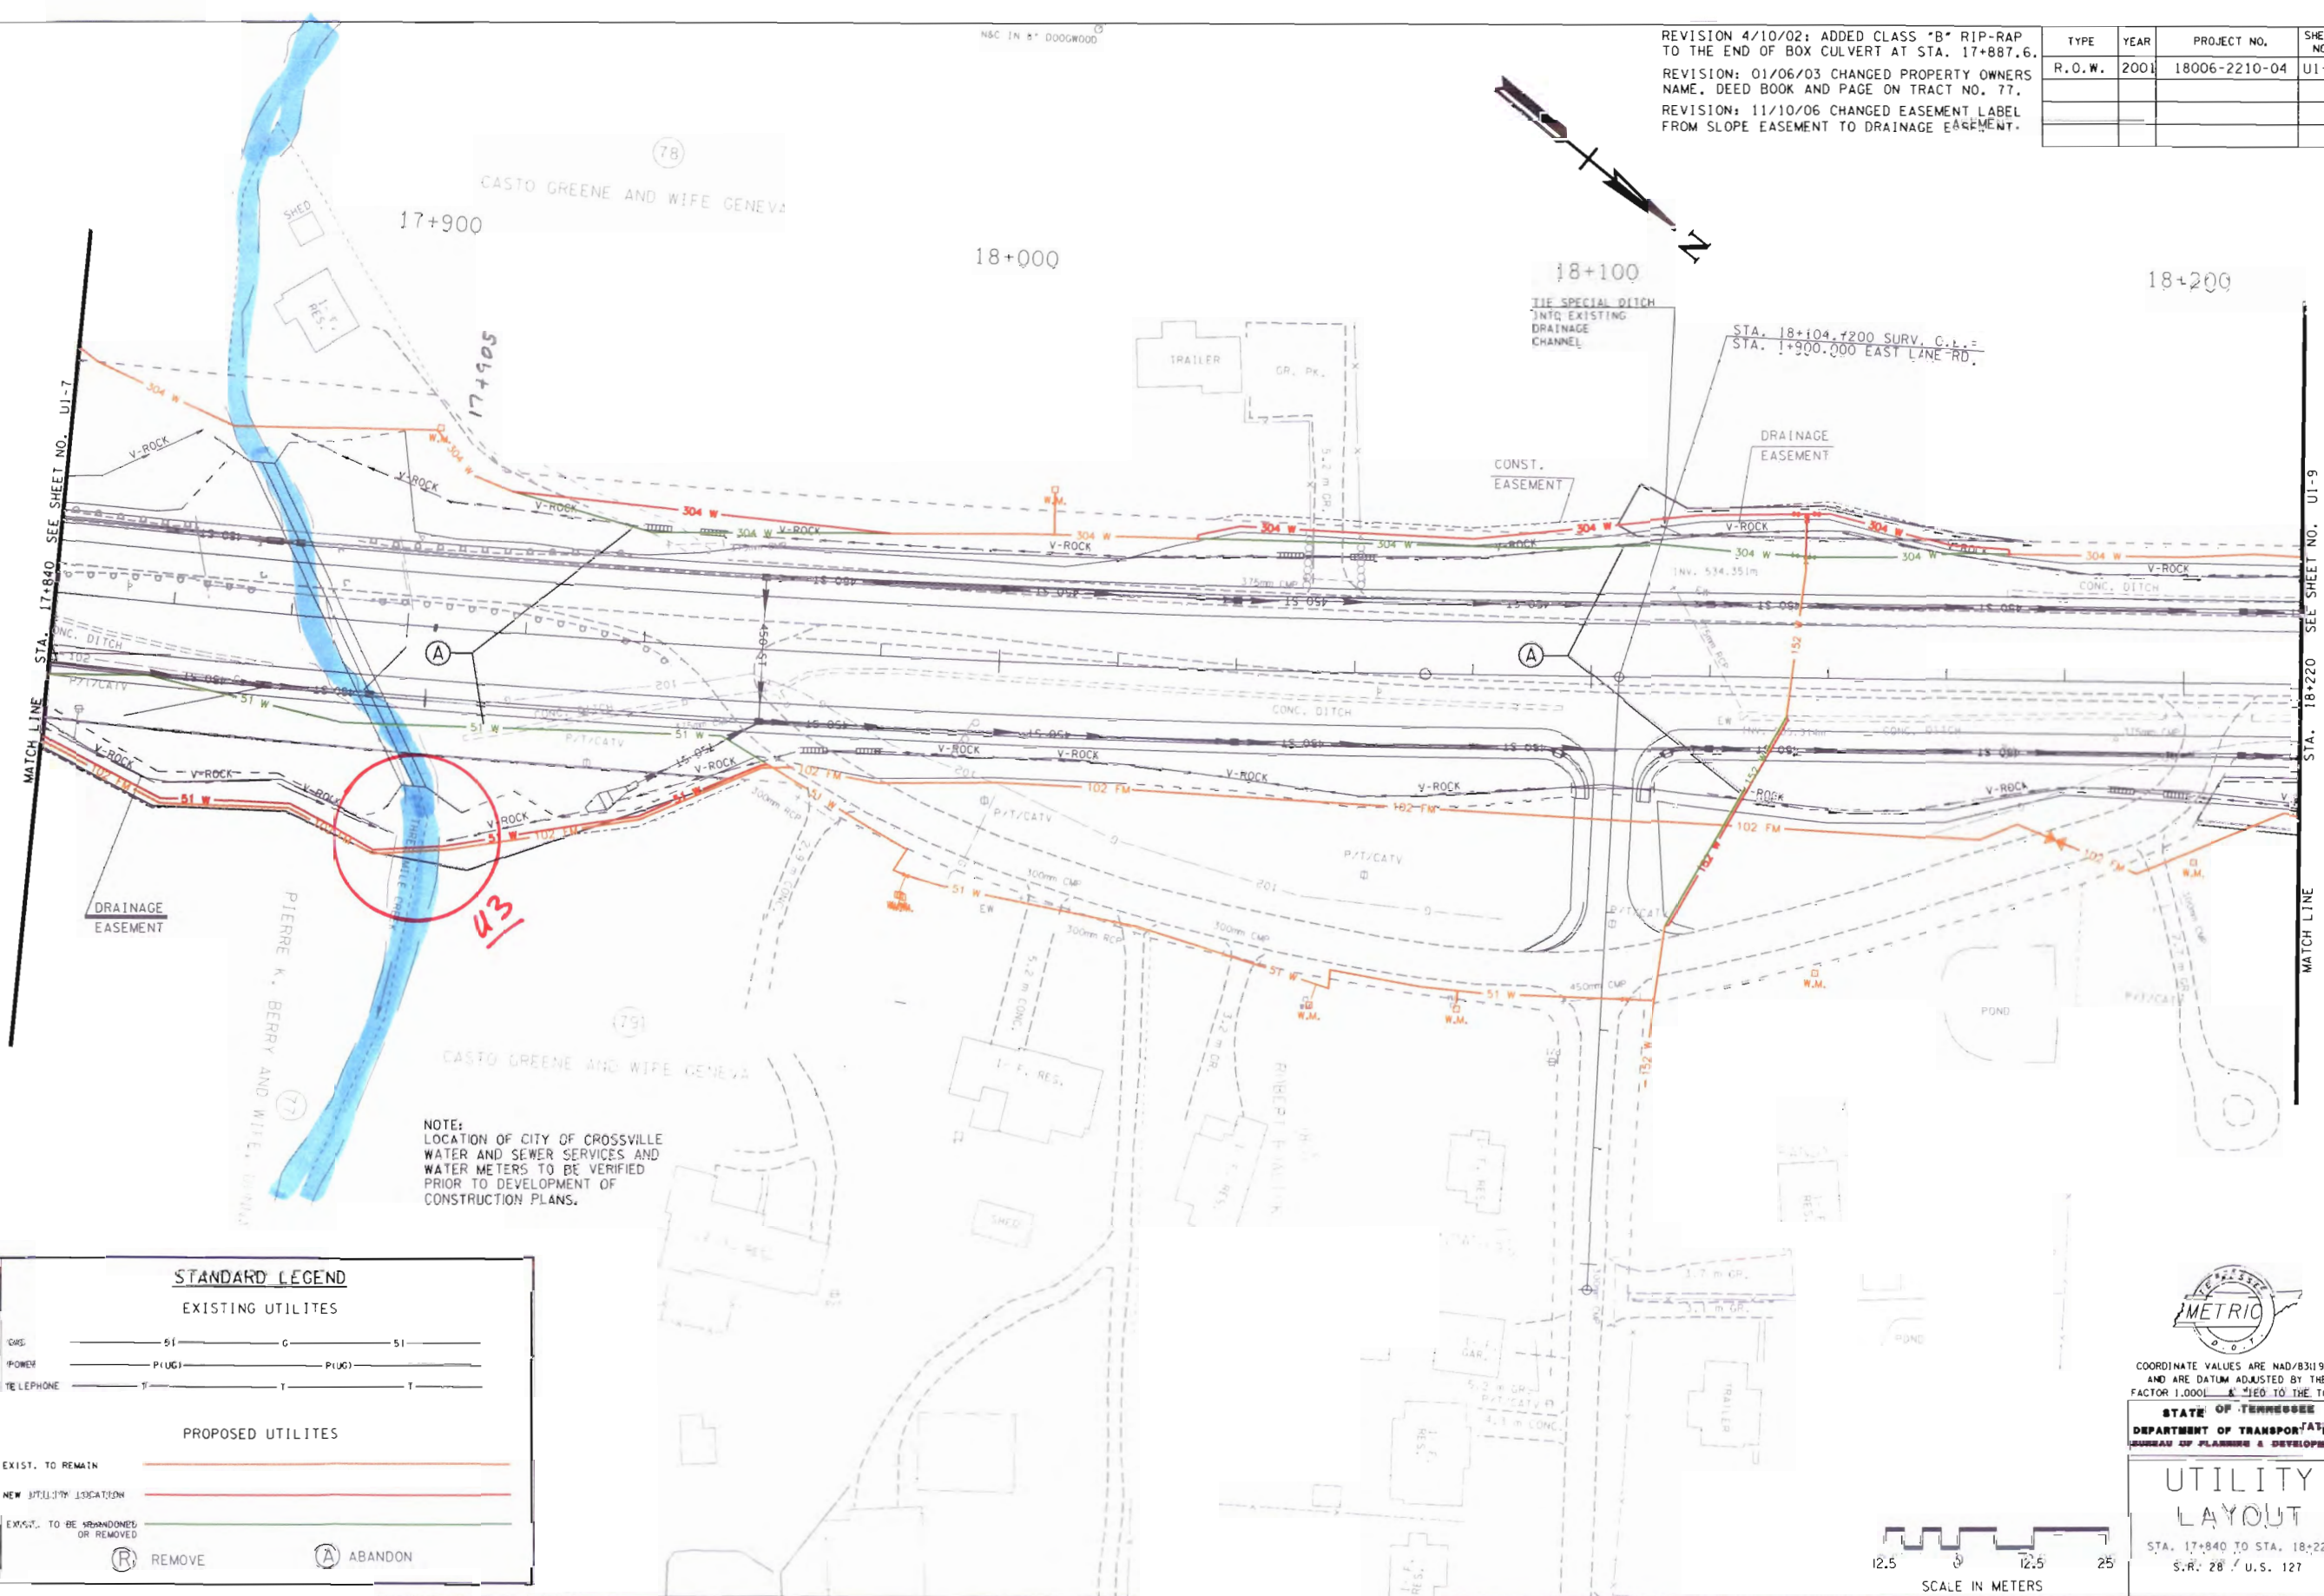




TENNESSEE D.O.T.  
DESIGN DIVISION  
FILE NO.

| TYPE   | YEAR | PROJECT NO.   | SHEET NO. |
|--------|------|---------------|-----------|
| R.O.W. | 2001 | 18006-2210-04 | U1-9      |
|        |      |               |           |
|        |      |               |           |

REVISION 1/06/03: INCREASED SIZE  
OF FIELD ENTRANCE RT. OF STA.  
18+287 FROM 3 TO 9m.

REVISION 3/20/07: ADDED BUSINESS  
ENTRANCE RT. STA. 18+323.77.


REVISION 11/02/07: MOVED PRIVATE DR.  
RT. FROM STA. 18+393 TO STA. 18+398.  
CHANGED CONSTRUCTION EASEMENT  
ON TRACT NO. 87.

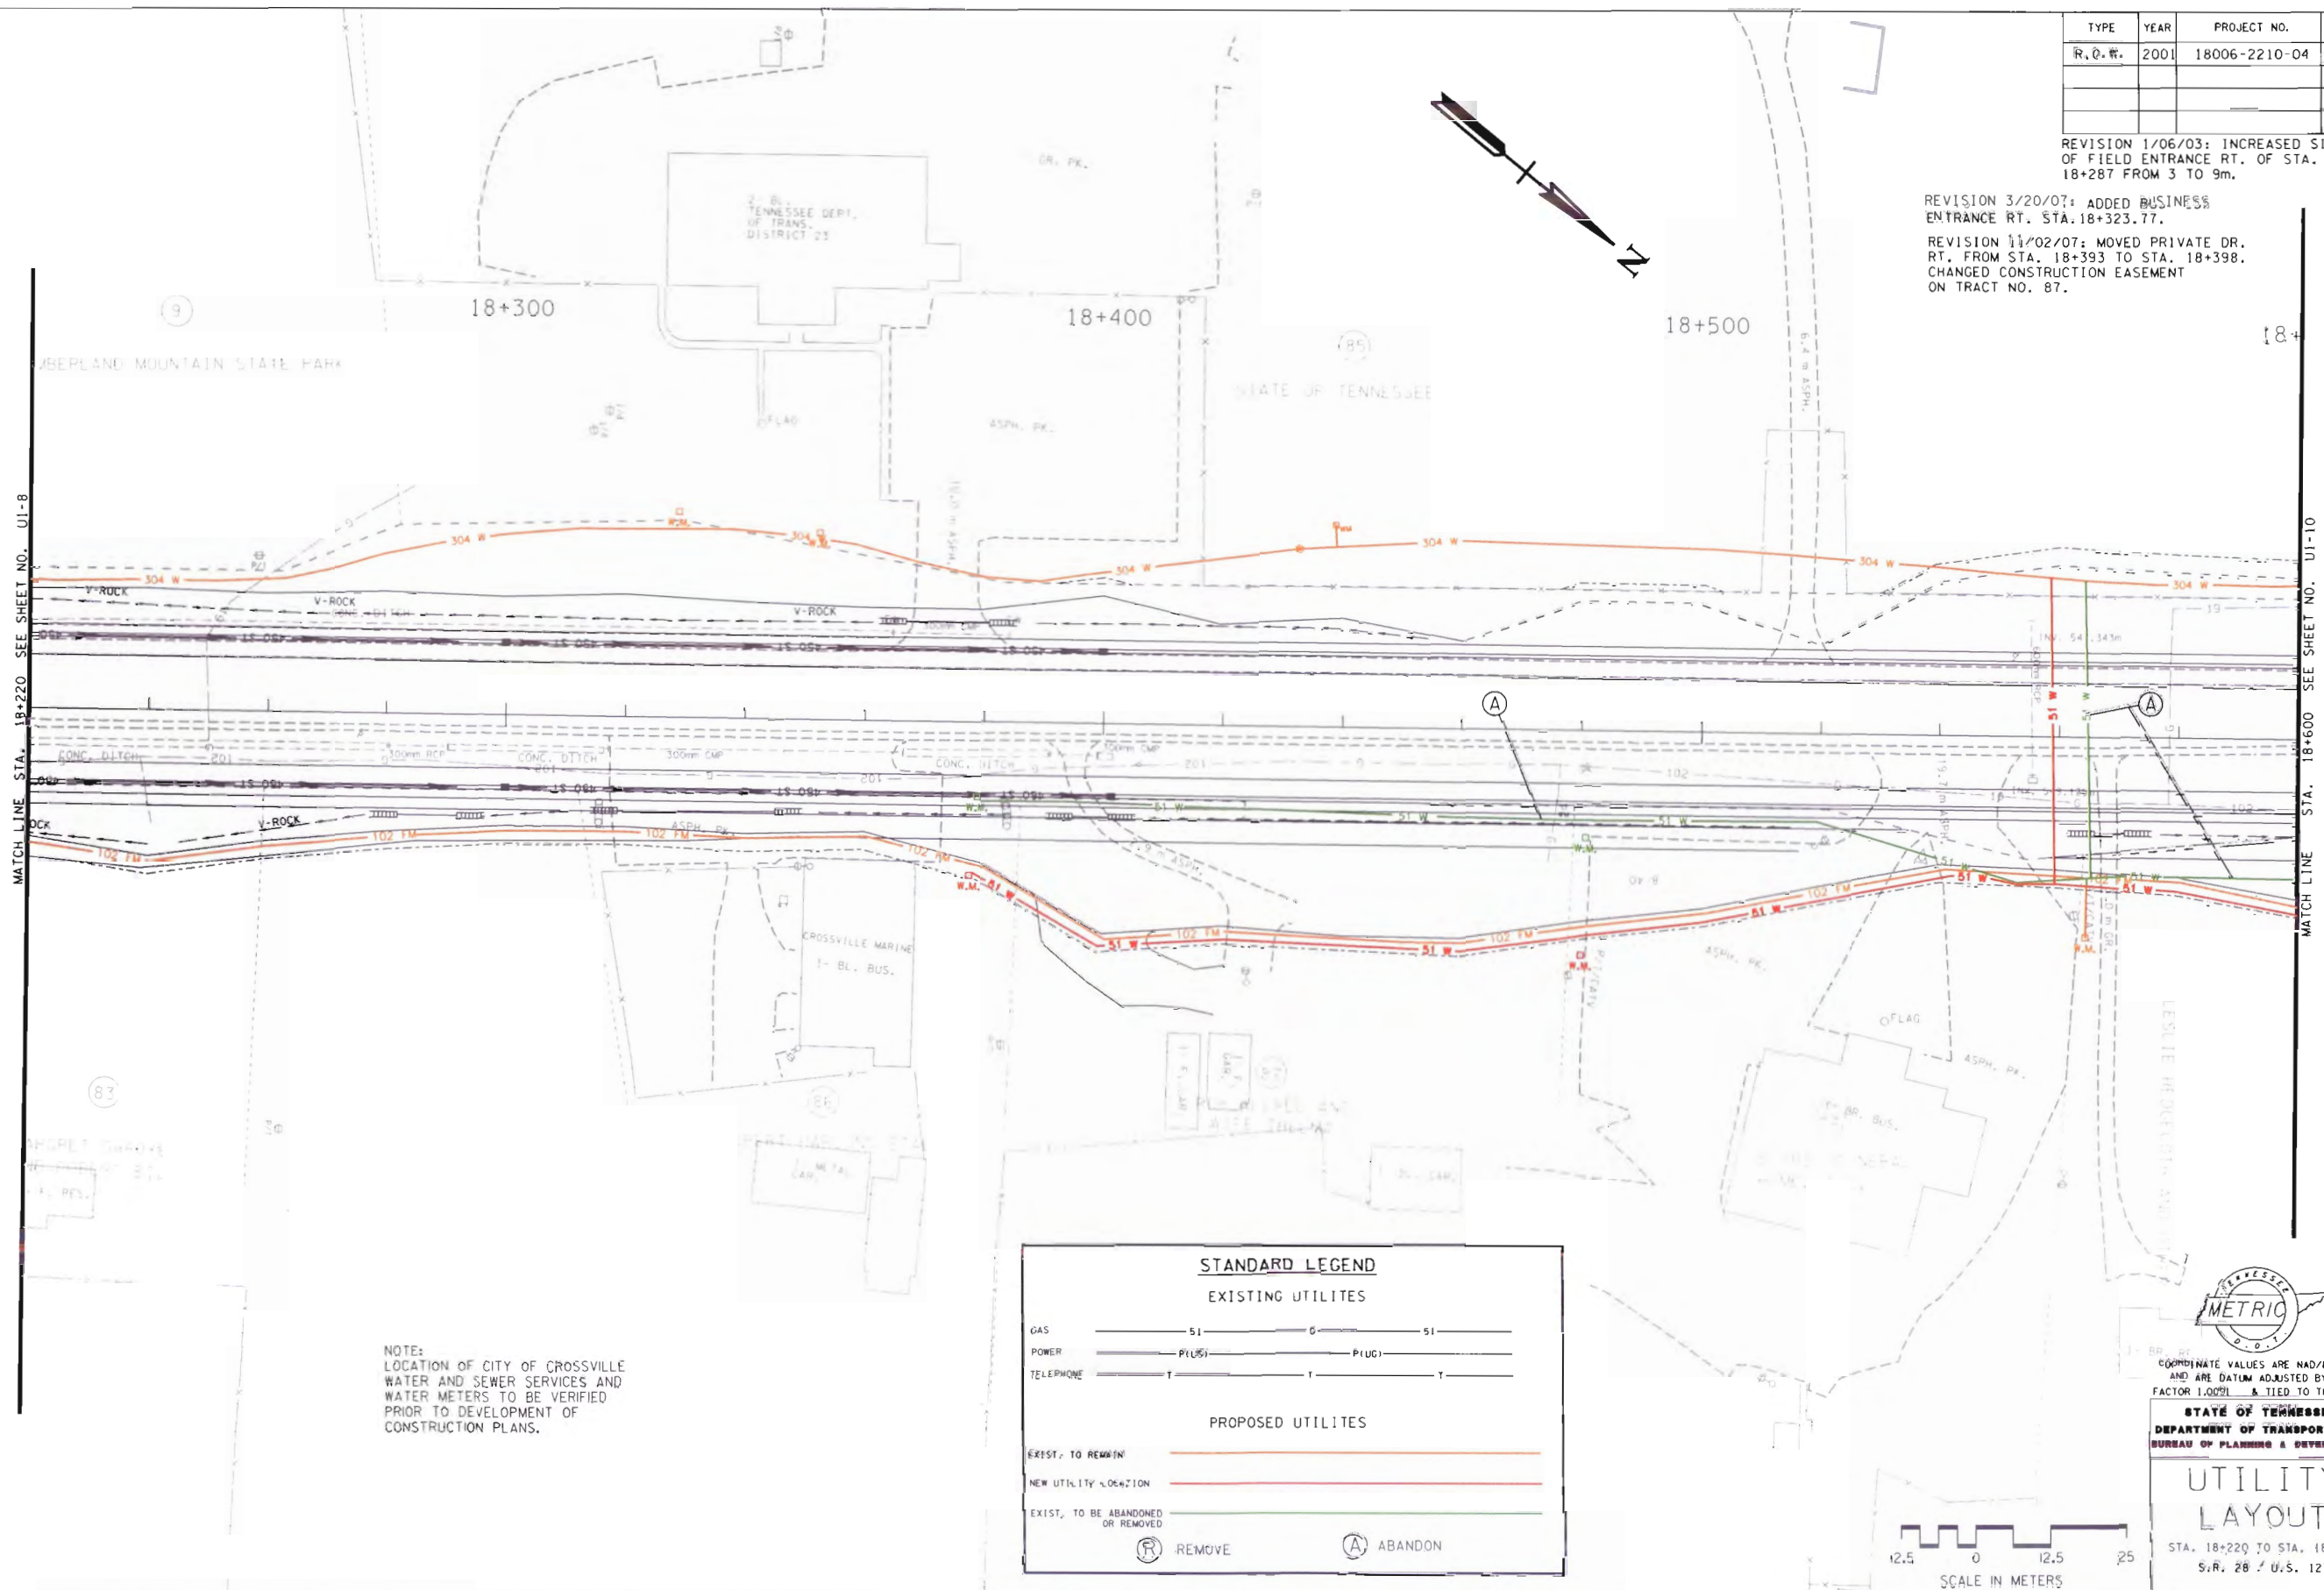



|                  |
|------------------|
| TENNESSEE D.O.T. |
| DESIGN DIVISION  |
| FILE NO.         |

| TYPE   | YEAR | PROJECT NO.   | SHEET NO. |
|--------|------|---------------|-----------|
| R.O.W. | 2001 | 18006-2210-04 | U1-10     |
|        |      |               |           |
|        |      |               |           |

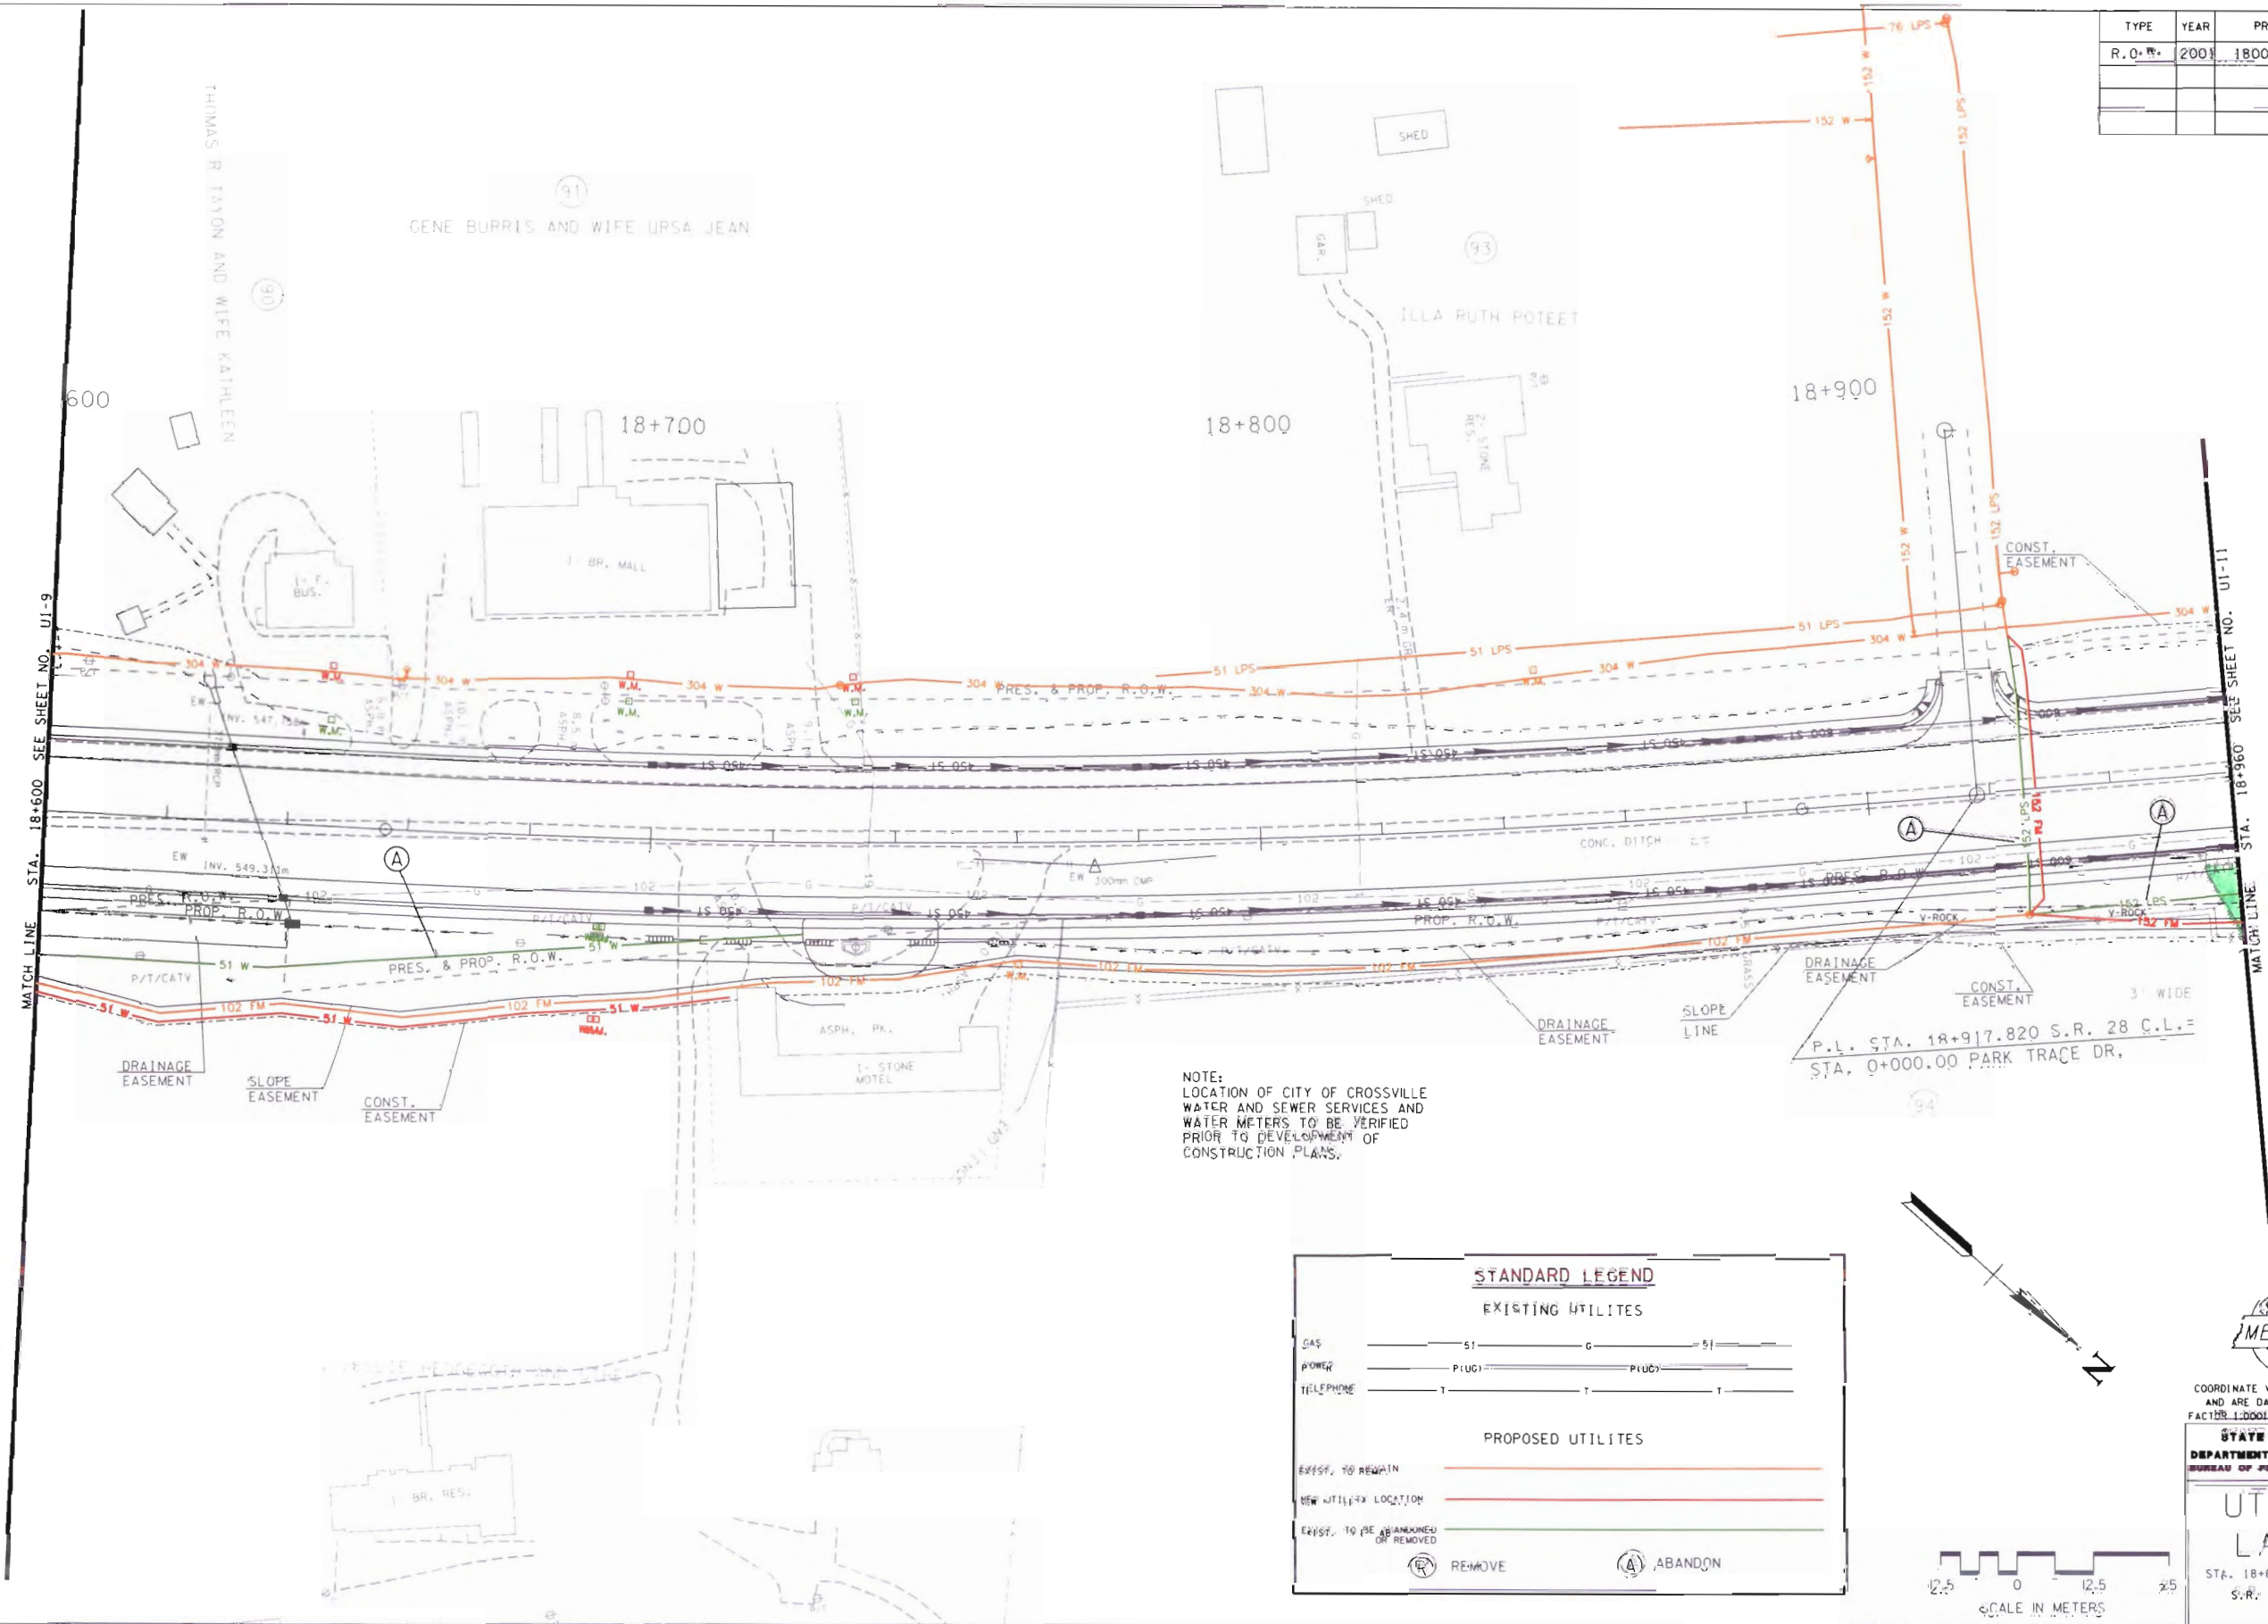

44







TENNESSEE D.O.T.  
DESIGN DIVISION  
FILE NO.

**STANDARD LEGEND**

**EXISTING UTILITIES**

GAS ——— S1 ——— G ——— S1 ———  
POWER ——— P(UG) ——— P(UG) ———  
TELEPHONE ——— T ——— T ———

**PROPOSED UTILITIES**

EXIST. TO REMAIN ———  
NEW UTILITY LOCATION ———  
EXIST. TO BE ABANDONED OR REMOVED ———


(R) REMOVE (A) ABANDON

REVISION 05/30/06: ADDED RETAINING WALL  
AND MODIFIED STORM DRAINAGE SYSTEM  
DUE TO MEDICAL CENTER CONSTRUCTION.  
ADDED PROP. BUSINESS ENTRANCE AT  
STA. 19+710.4 RT. AND 2+540.00 LT.

| TYPE   | YEAR | PROJECT NO.   | SHEET NO. |
|--------|------|---------------|-----------|
| R.O.W. | 2001 | 18006-2210-04 | U1-12     |
|        |      |               |           |
|        |      |               |           |

STA. 19+320 SEE SHEET NO. U1-11

STA. 19+680 SEE SHEET NO. U1-13

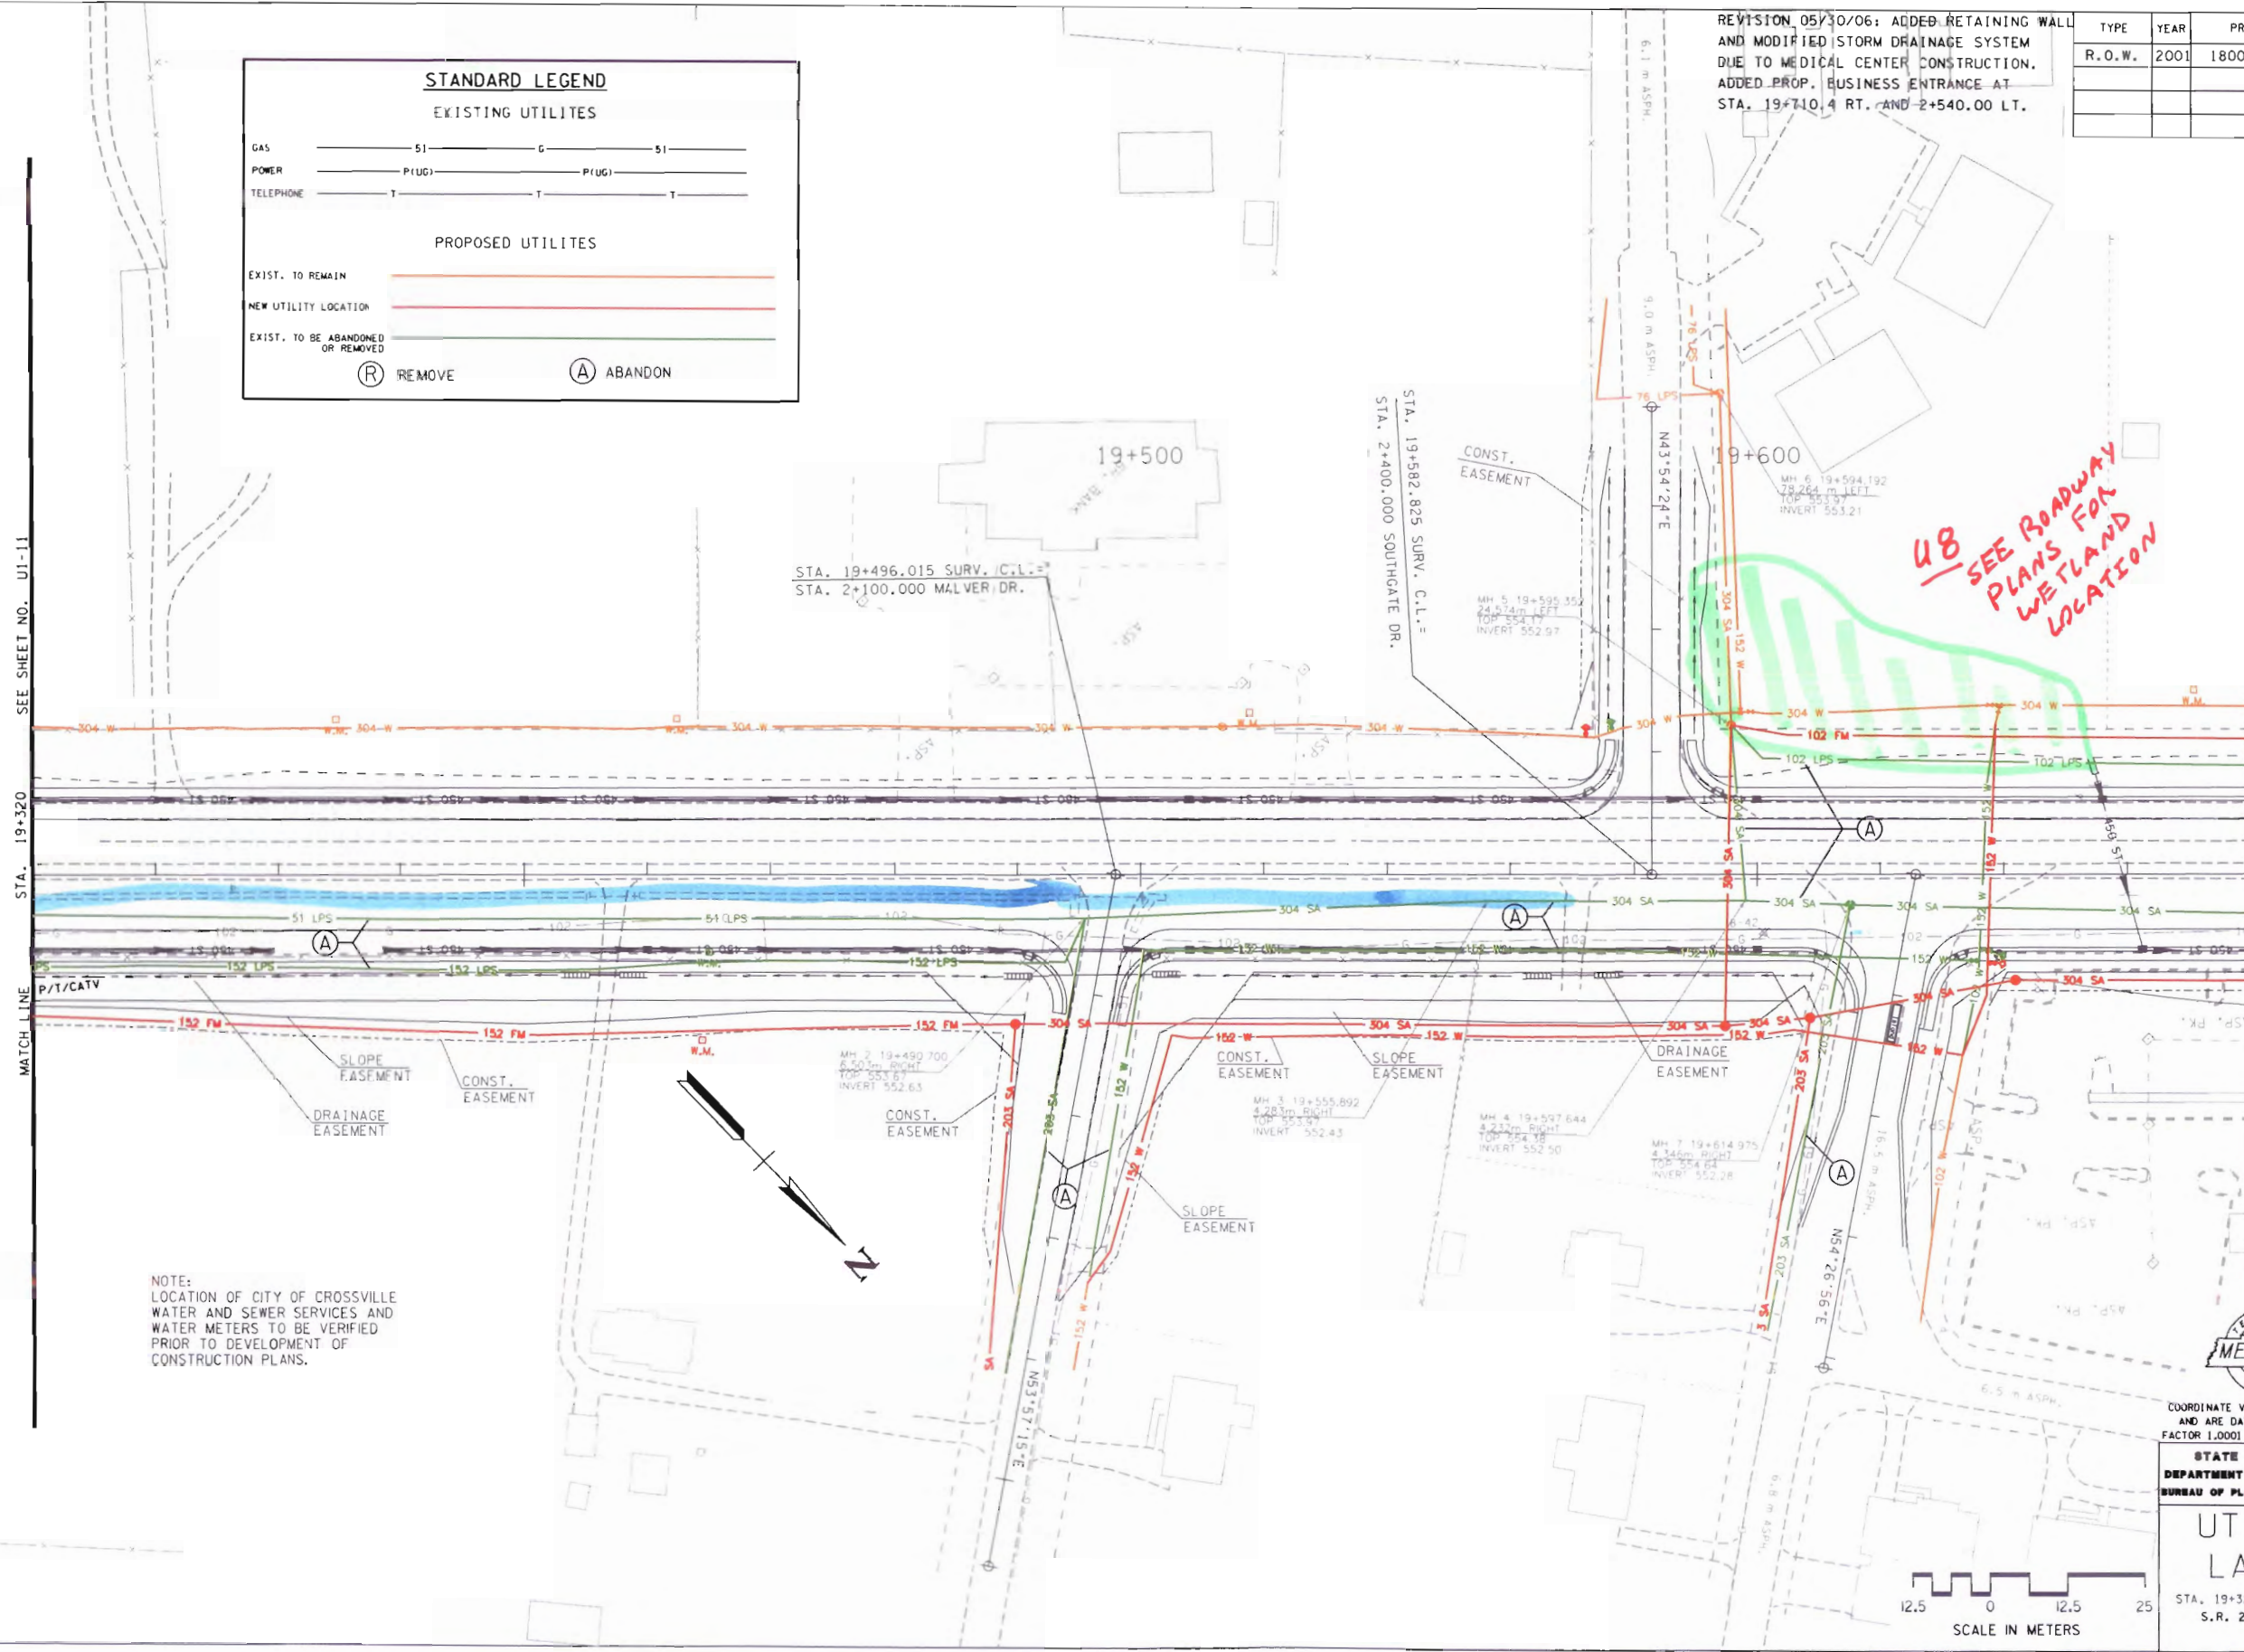

**METRIC**

COORDINATE VALUES ARE NAD(83)(1995)  
AND ARE DATUM ADJUSTED BY THE  
FACTOR 1.0001 & TIED TO THE TGRN.

STATE OF TENNESSEE  
DEPARTMENT OF TRANSPORTATION  
BUREAU OF PLANNING & DEVELOPMENT

**UTILITY LAYOUT**


STA. 19+320 TO STA. 19+680  
S.R. 28 / U.S. 127



TENNESSEE D.O.T.  
DESIGN DIVISION  
FILE NO.

REVISION 05/30/06: ADDED RETAINING WALL  
AND MODIFIED STORM DRAINAGE SYSTEM  
DUE TO MEDICAL CENTER CONSTRUCTION.  
ADDED PROP. BUSINESS ENTRANCE AT  
STA. 19+710.4 RT. AND 2+540.00 LT.


| TYPE   | YEAR | PROJECT NO.   | SHEET NO. |
|--------|------|---------------|-----------|
| R.O.W. | 2001 | 18006-2210-04 | U1-13     |
|        |      |               |           |
|        |      |               |           |

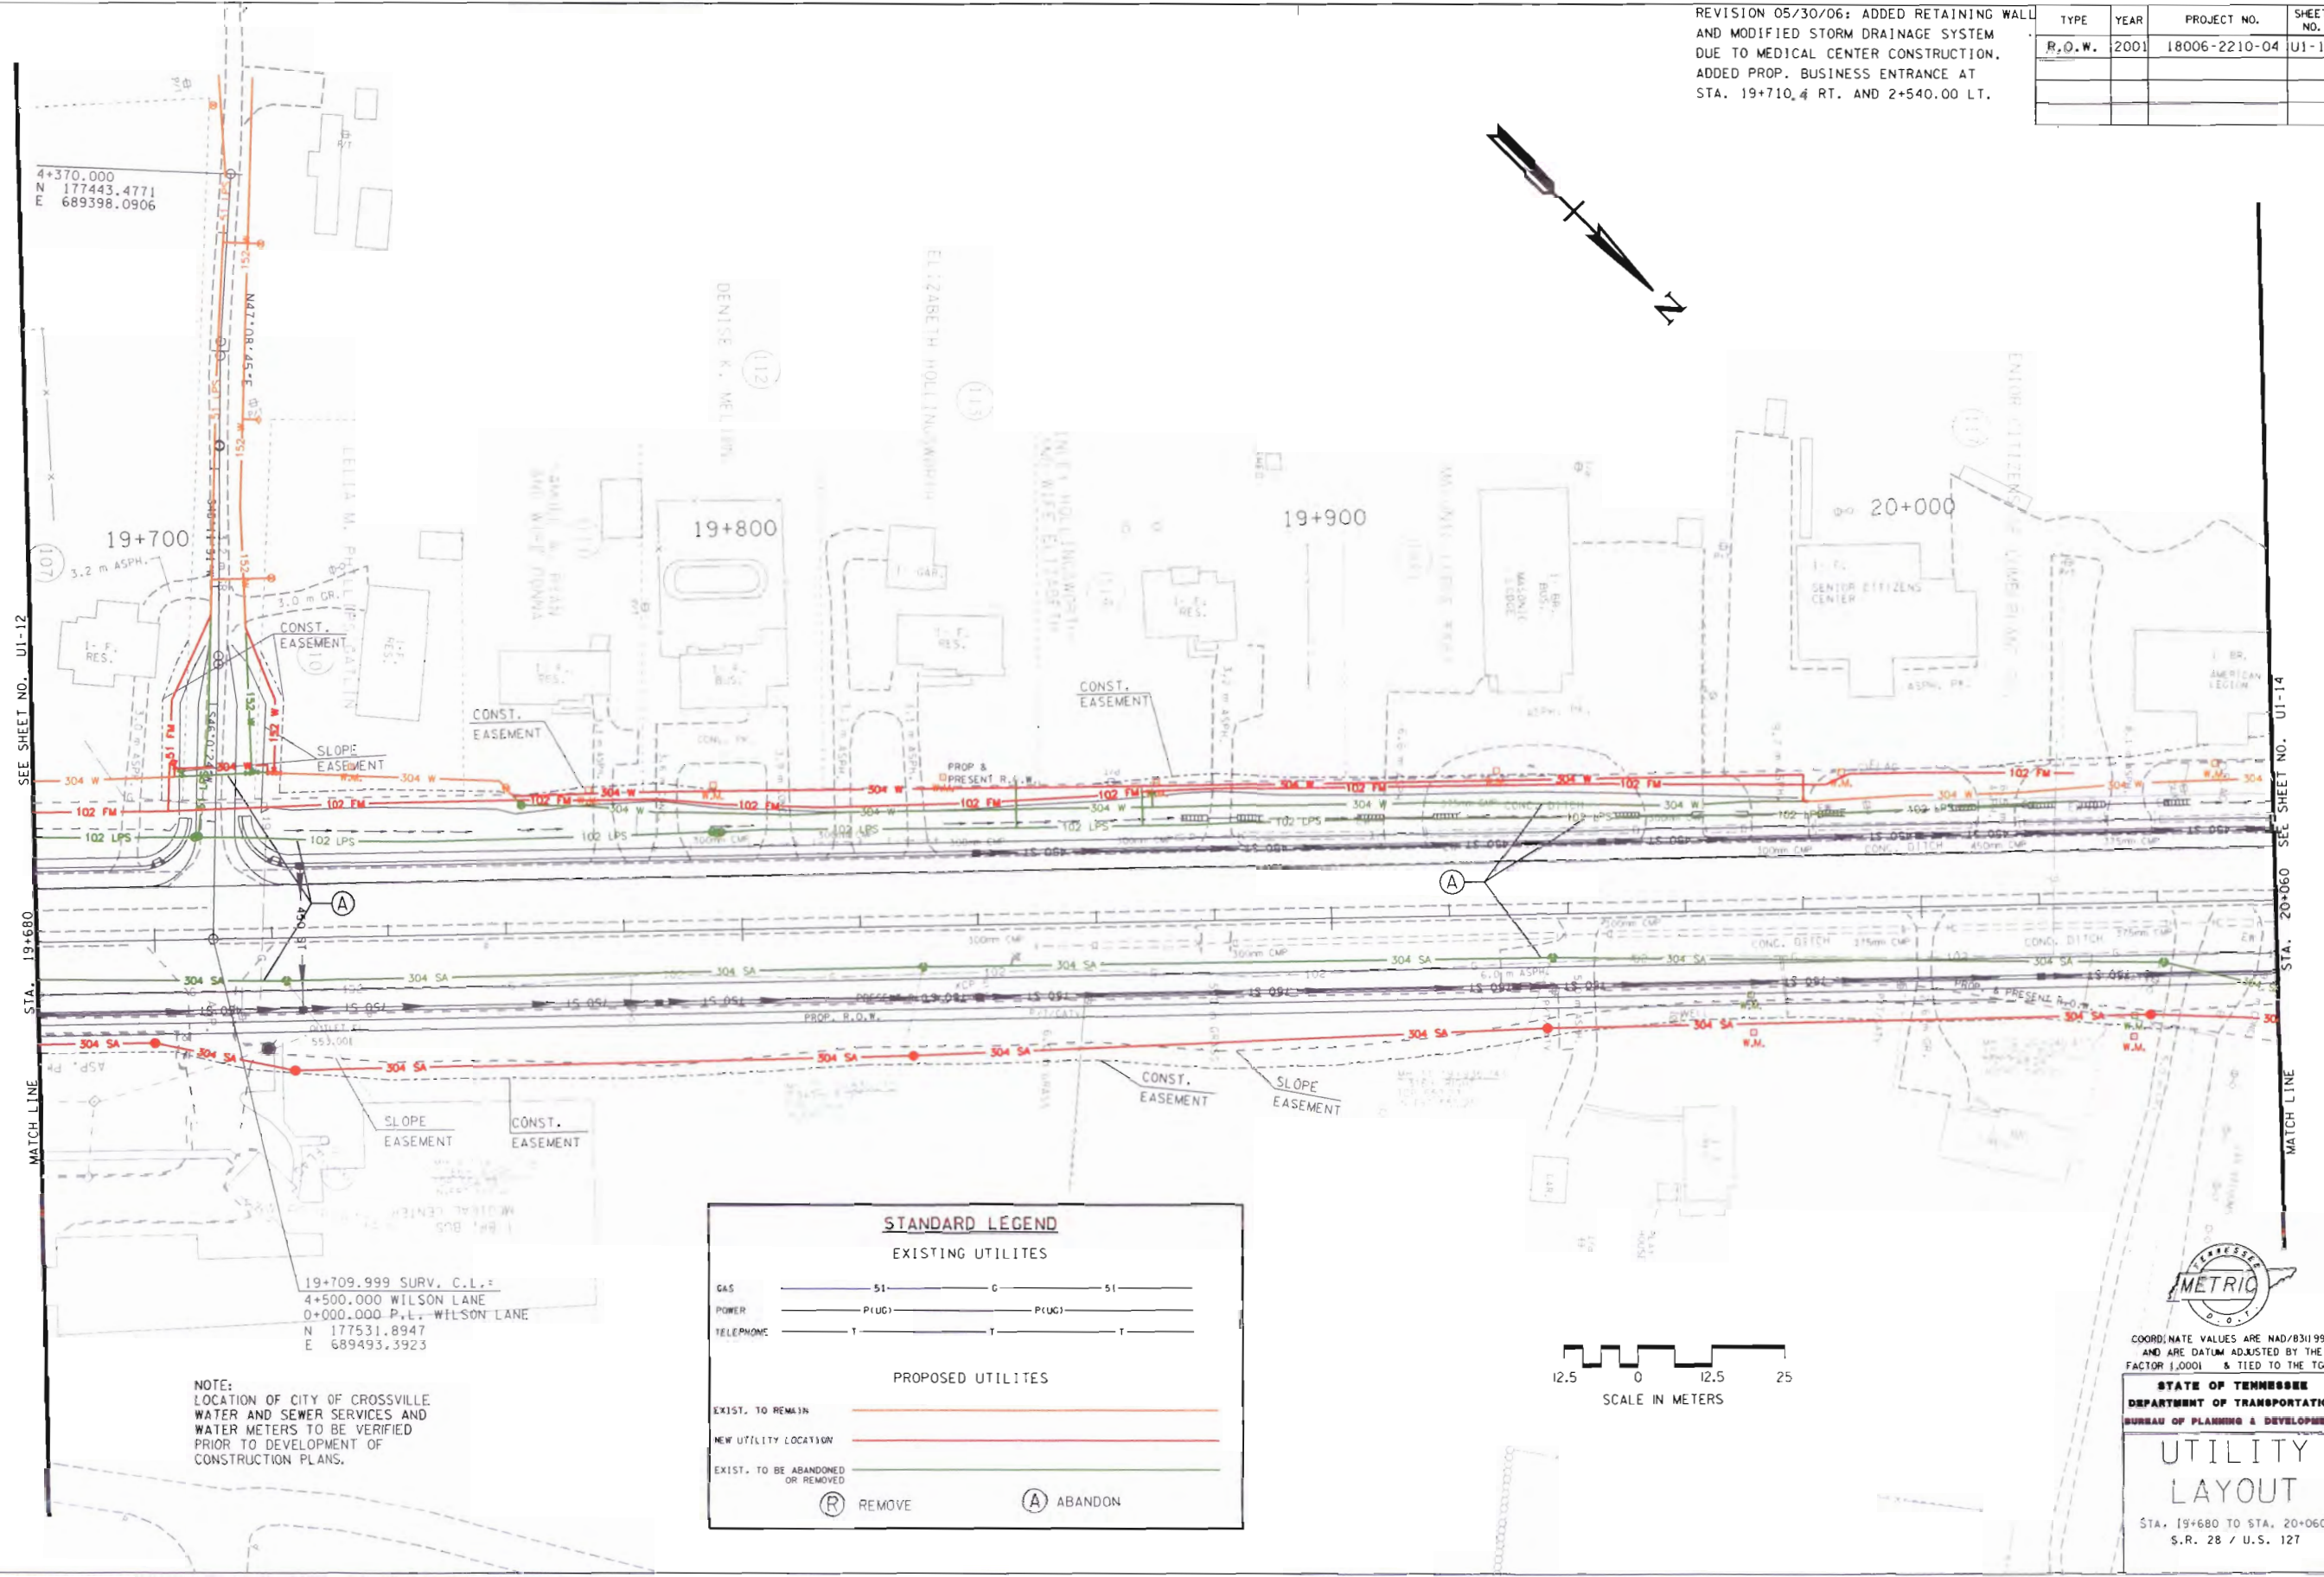




TENNESSEE D.O.T.  
DESIGN DIVISION  
FILE NO.

| TYPE   | YEAR | PROJECT NO.   | SHEET NO. |
|--------|------|---------------|-----------|
| R.O.W. | 2001 | 18006-2210-04 | U1-14     |
|        |      |               |           |
|        |      |               |           |

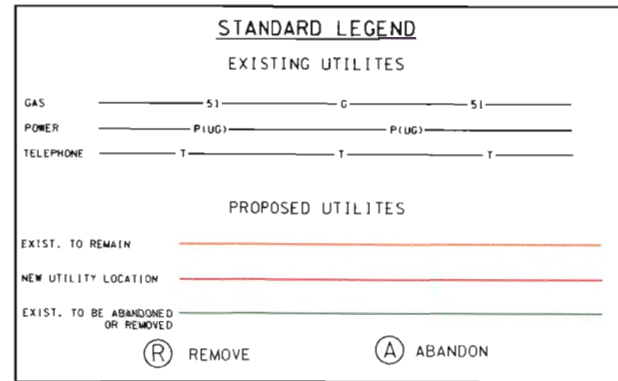

NOTE:  
LOCATION OF CITY OF CROSSVILLE  
WATER AND SEWER SERVICES AND  
WATER METERS TO BE VERIFIED  
PRIOR TO DEVELOPMENT OF  
CONSTRUCTION PLANS.

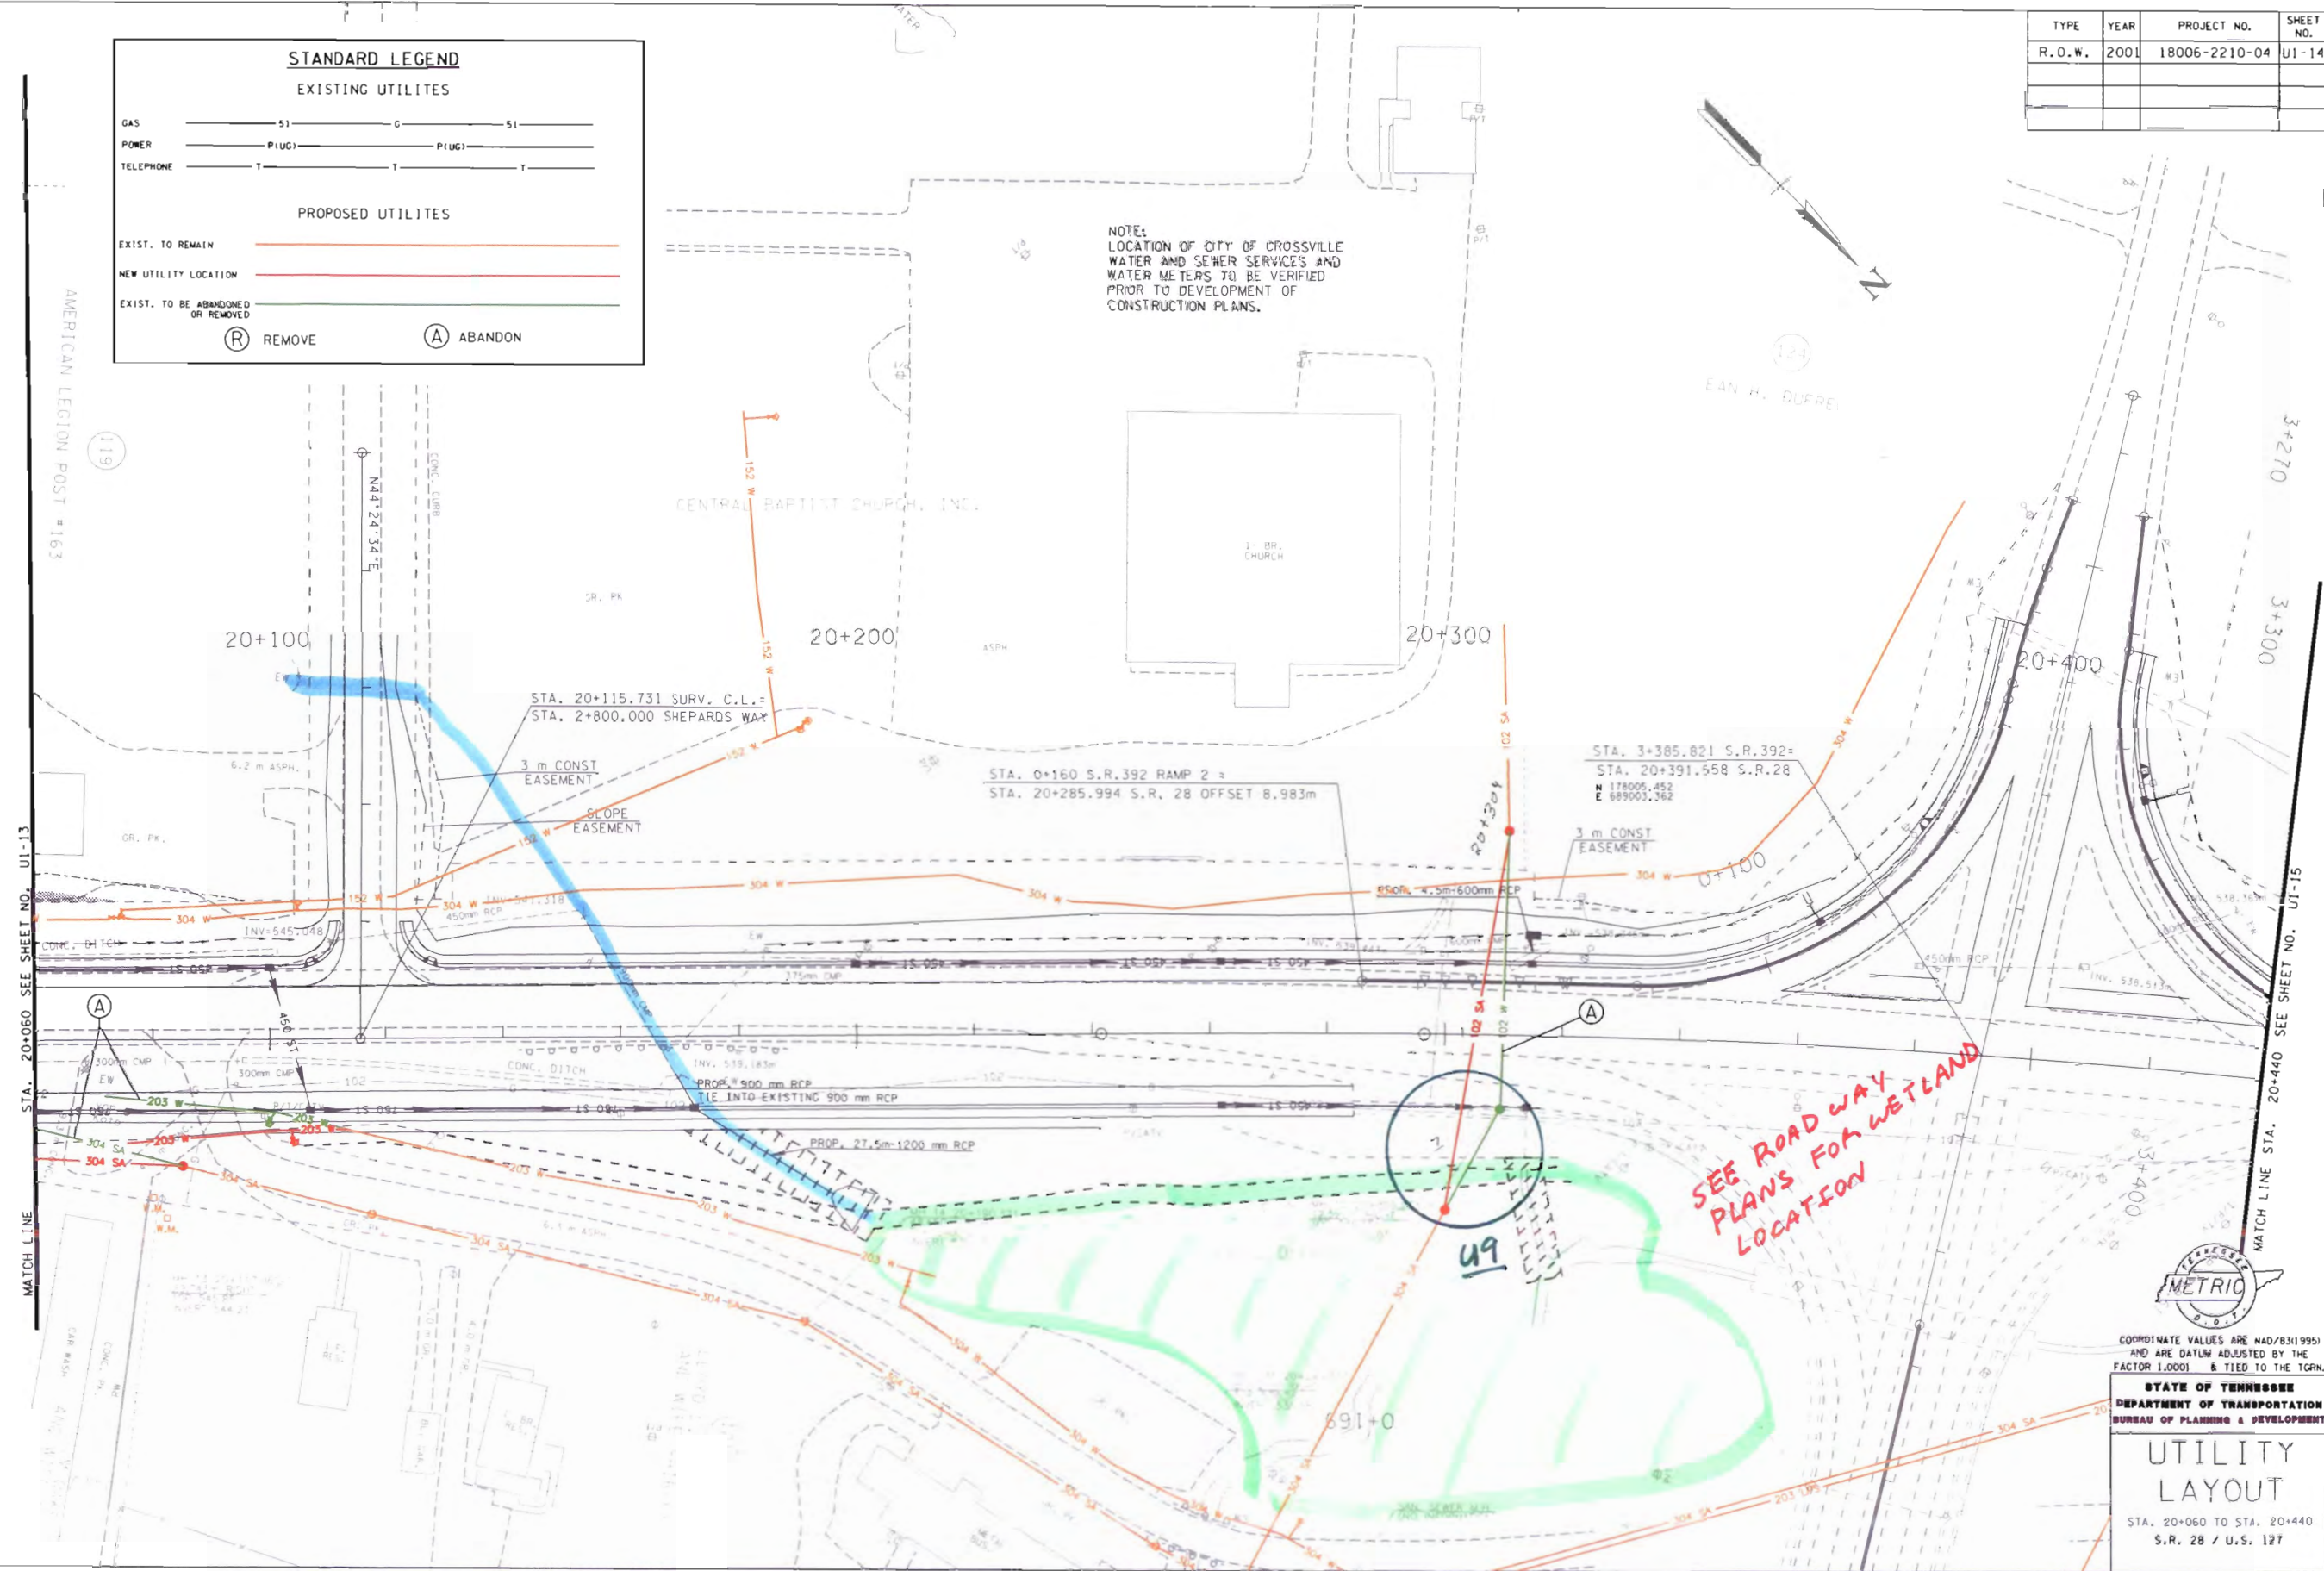




| STANDARD LEGEND                   |                     |
|-----------------------------------|---------------------|
| EXISTING UTILITIES                |                     |
| GAS                               | — 51 — 51 — 51 —    |
| POWER                             | — P (UG) — P (UG) — |
| TELEPHONE                         | — T — T — T —       |
| PROPOSED UTILITIES                |                     |
| EXIST. TO REMAIN                  | — (Red line) —      |
| NEW UTILITY LOCATION              | — (Red line) —      |
| EXIST. TO BE ABANDONED OR REMOVED | — (Green line) —    |
| (R) REMOVE                        | (A) ABANDON         |

| TYPE   | YEAR | PROJECT NO.   | SHEET NO. |
|--------|------|---------------|-----------|
| R.O.W. | 2001 | 18006-2210-04 | U1-15     |
|        |      |               |           |
|        |      |               |           |

REVISION 4/10/02: REMOVED PROPERTY OWNERS ADDRESSES FROM TRACT NO'S. 122, AND 125.

REVISION 03/12/03: CHANGED PROPERTY OWNERS NAME ON TRACT NOS. 130.

REVISION 07/20/04: ADDED 7.0 m CURB CUT LEFT AT STA. 20+639.

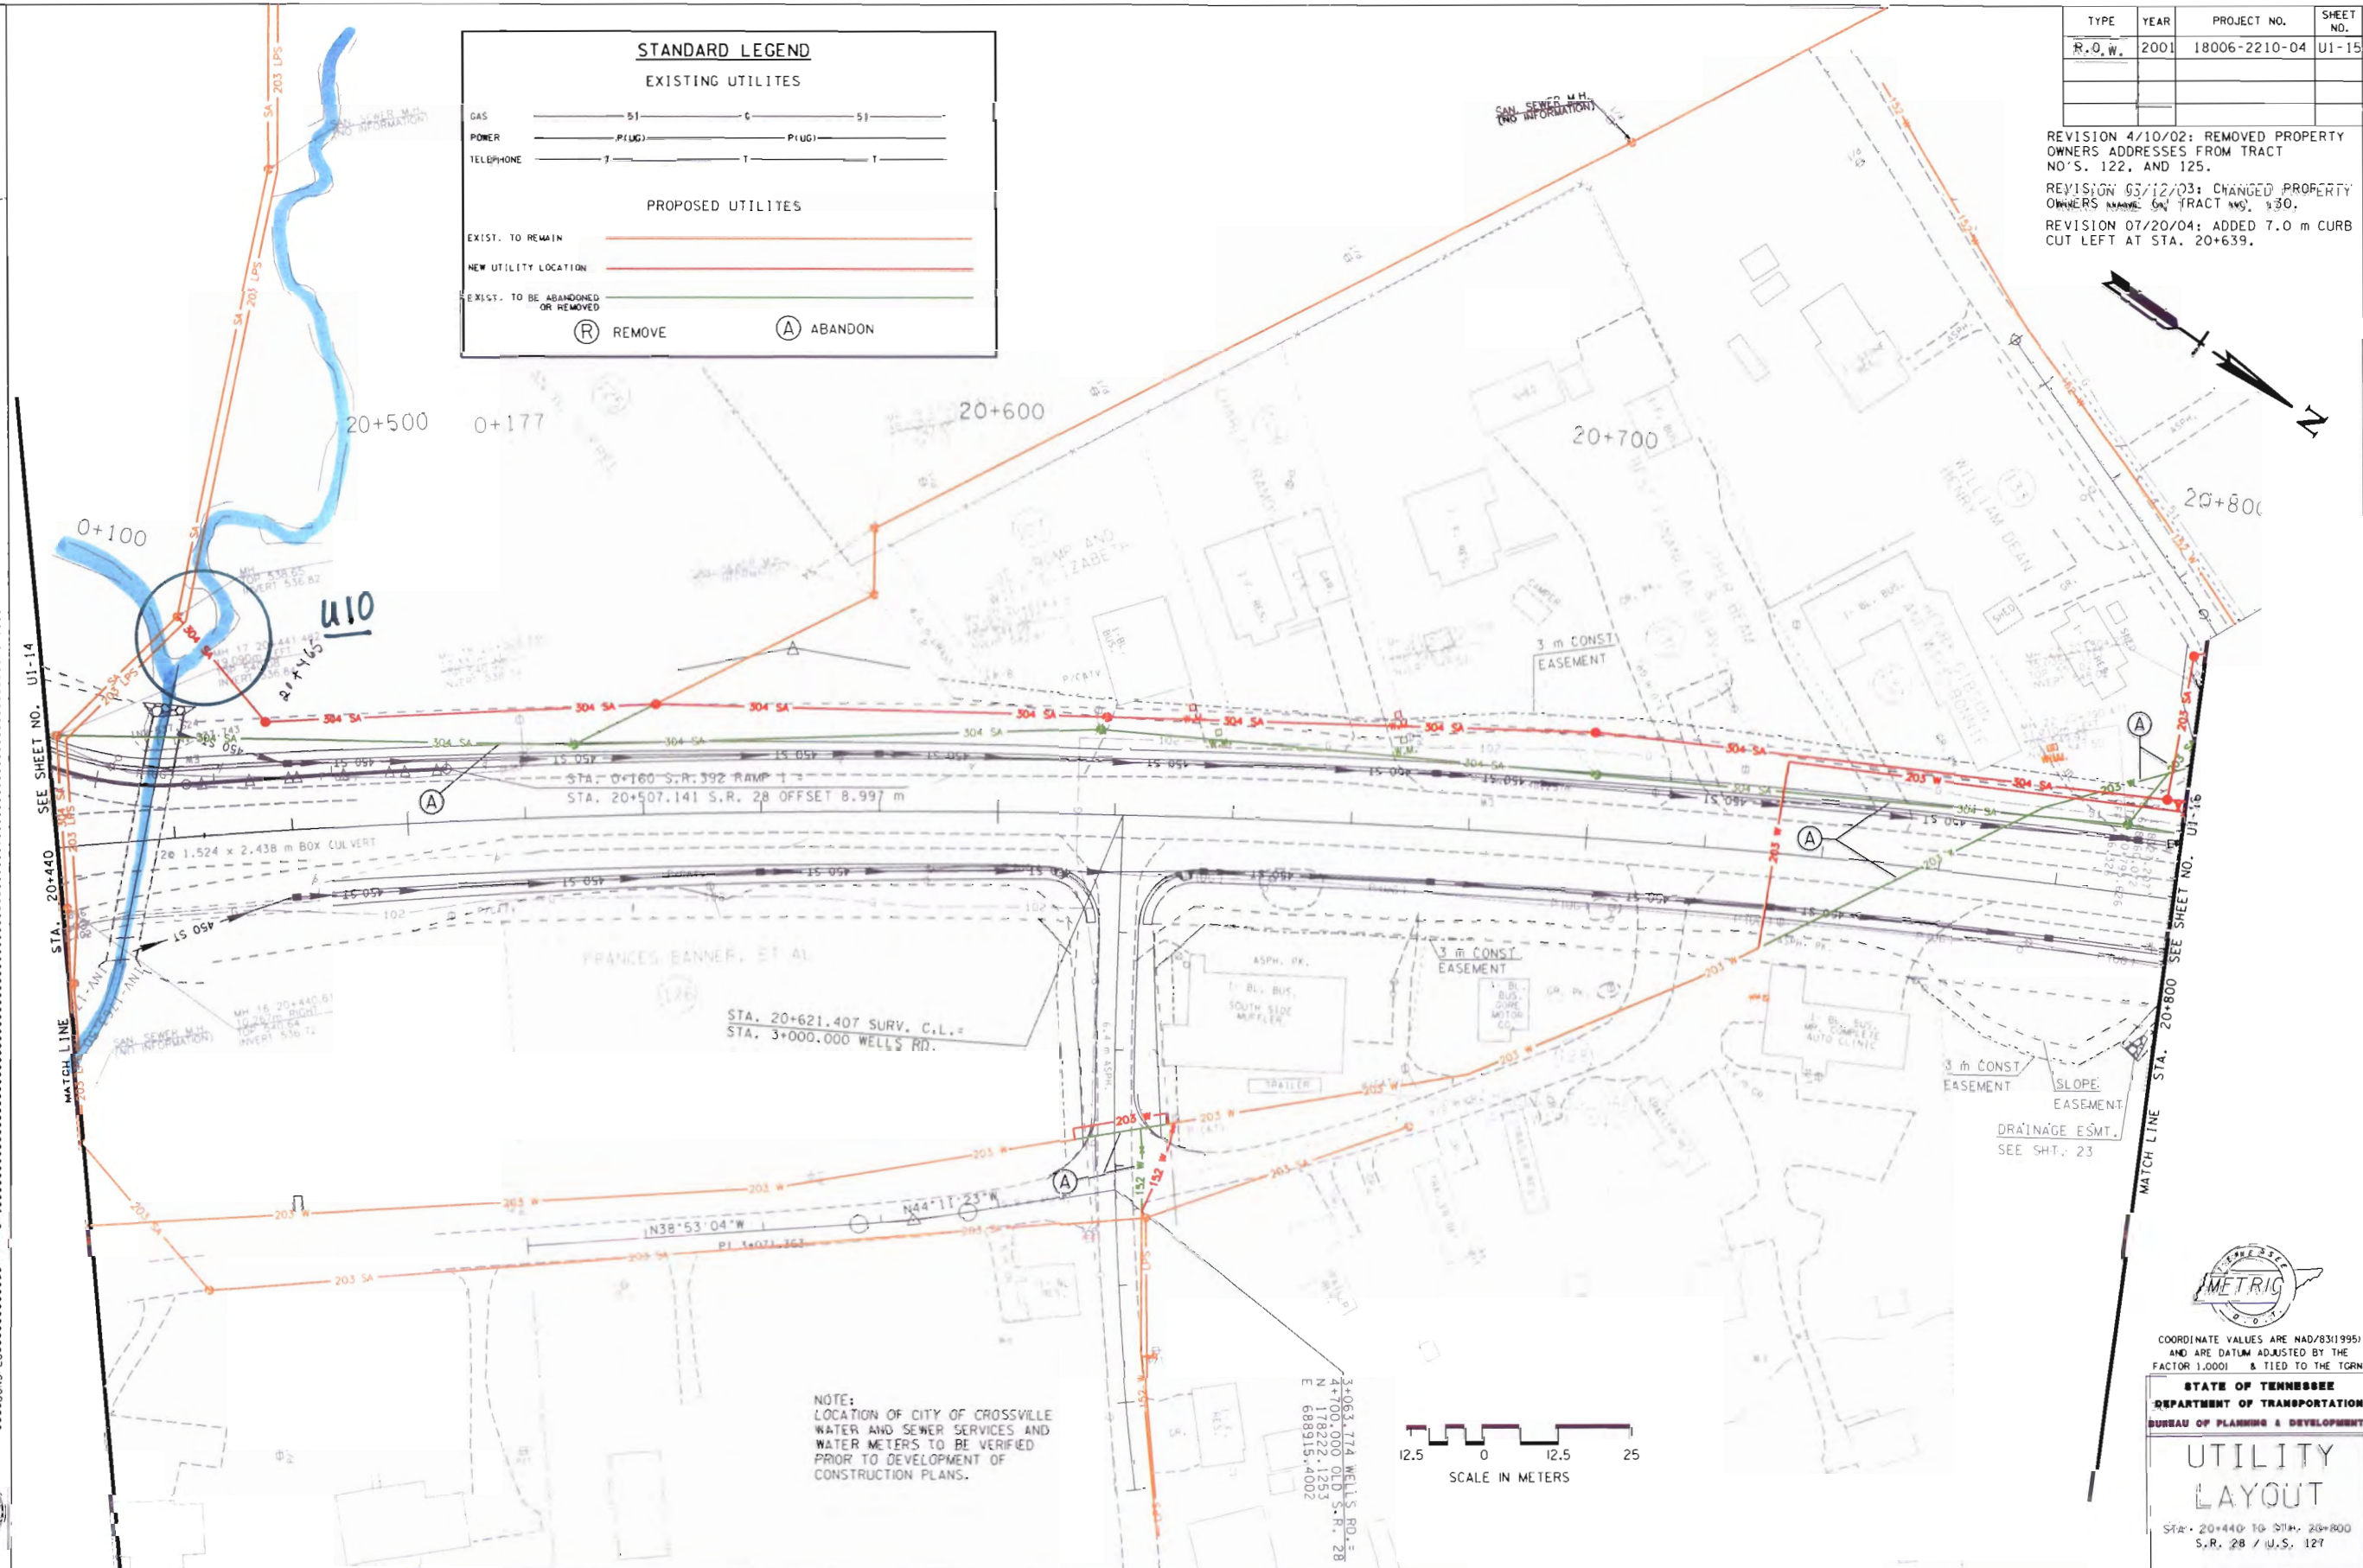




TENNESSEE D.O.T.  
DESIGN DIVISION  
FILE NO.

REVISION 1/06/03: CHANGED PROPERTY OWNERS NAME ON TRACT NO. 134.


| TYPE   | YEAR | PROJECT NO.   | SHEET NO. |
|--------|------|---------------|-----------|
| R.O.W. | 2001 | 18006-2210-04 | U1-16     |
|        |      |               |           |
|        |      |               |           |

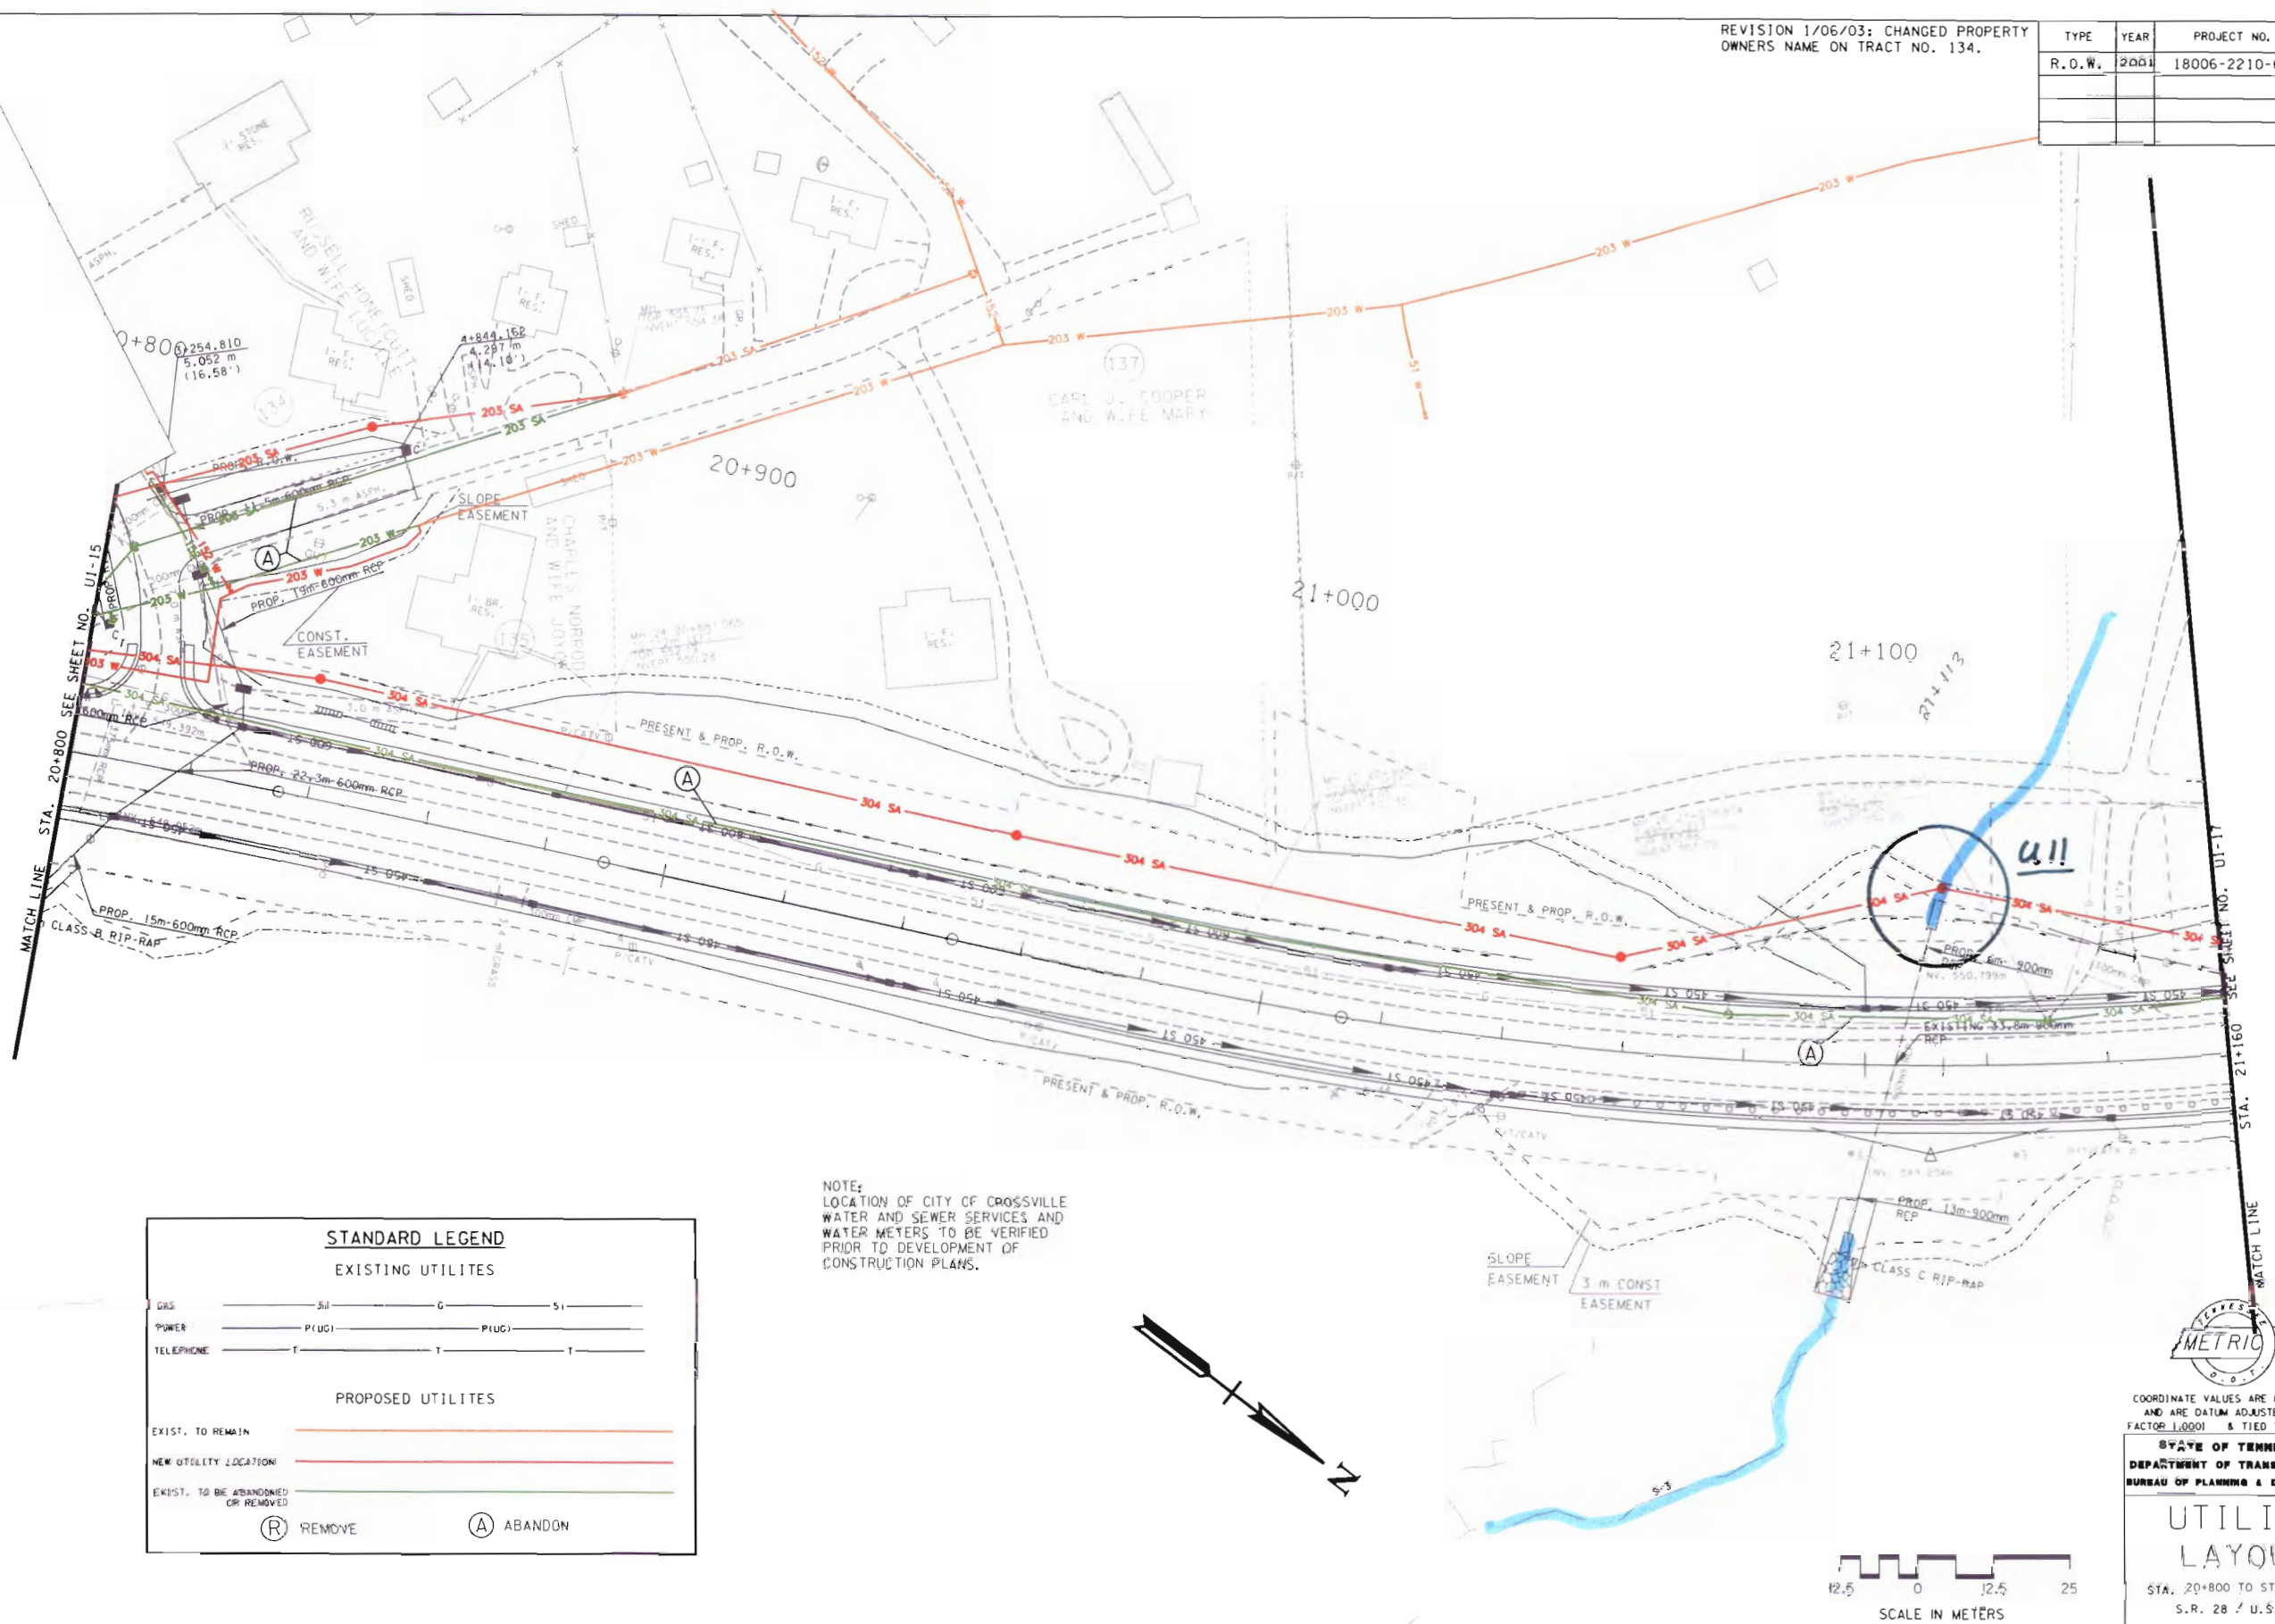



TENNESSEE D.O.T.  
DESIGN DIVISION  
FILE NO.

| TYPE   | YEAR | PROJECT NO.   | SHEET NO. |
|--------|------|---------------|-----------|
| R.O.W. | 2001 | 18006-2210-04 | U1-17     |
|        |      |               |           |
|        |      |               |           |

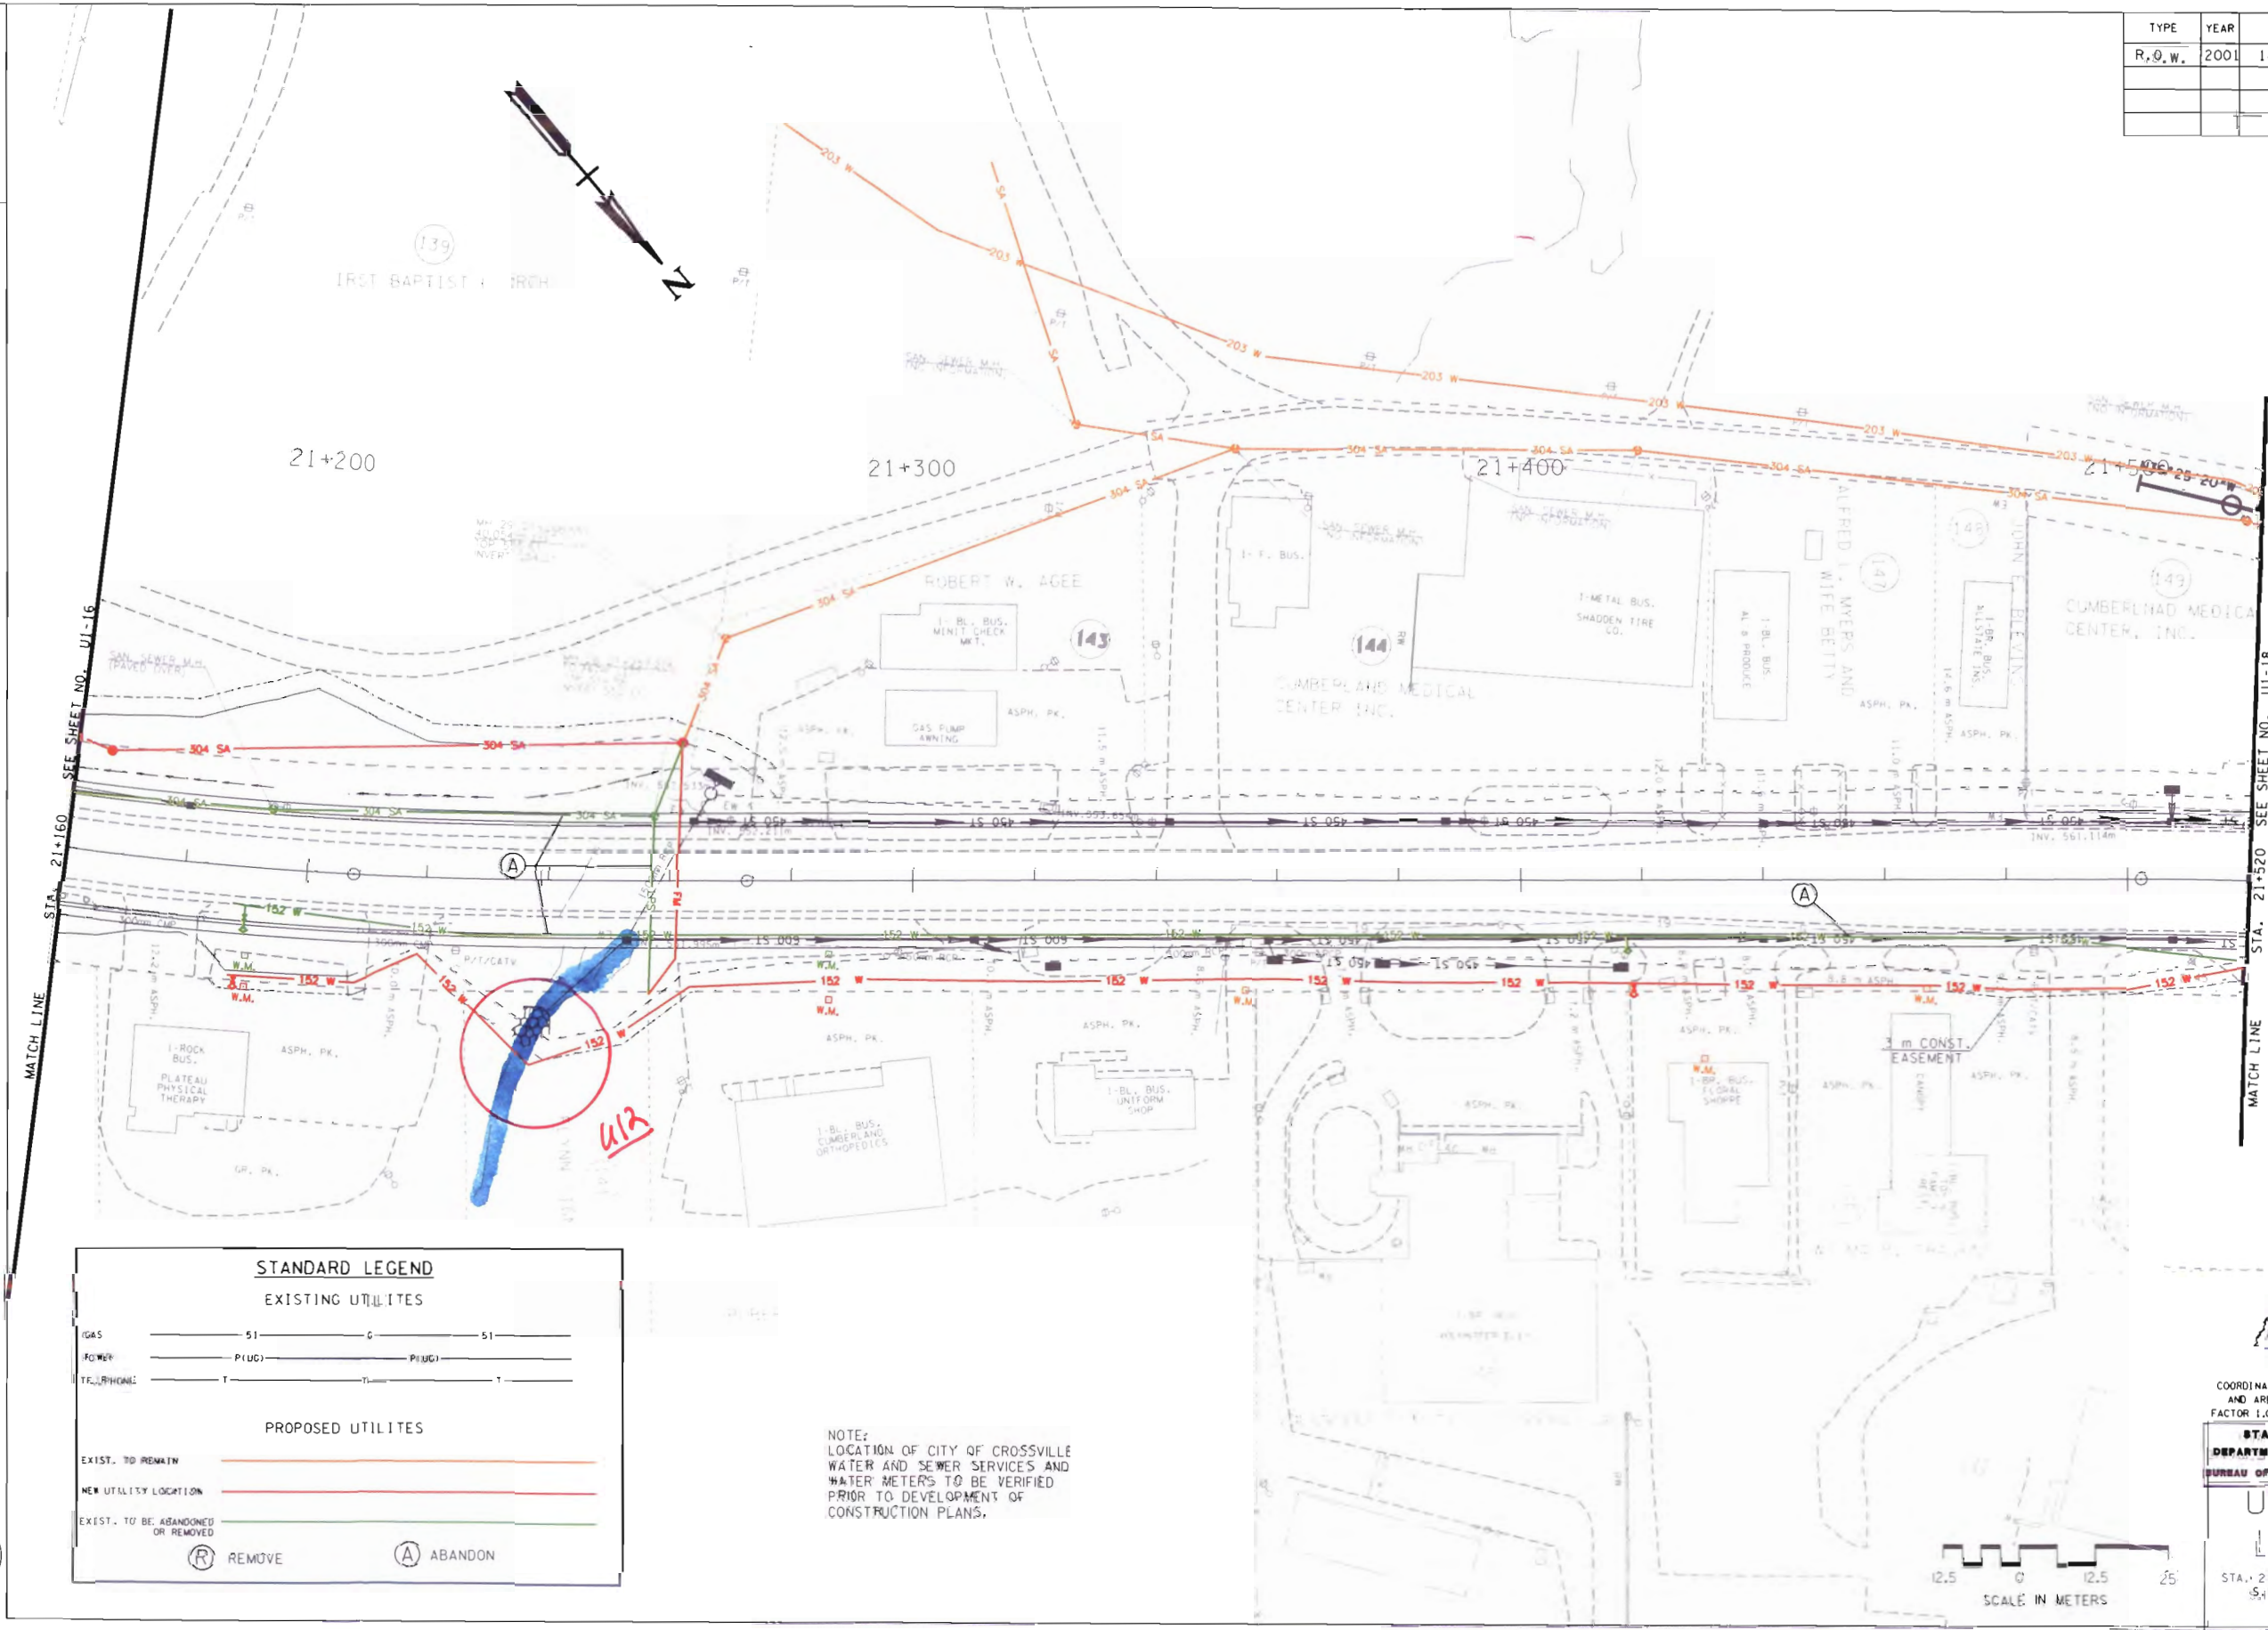

| STANDARD LEGEND                   |                  |        |            |
|-----------------------------------|------------------|--------|------------|
| EXISTING UTILITIES                |                  |        |            |
| GAS                               | — SI —           | G      | — SI —     |
| POWER                             | — P (UG) —       | P (UG) | — P (UG) — |
| TELEPHONE                         | — T —            | T      | — T —      |
| PROPOSED UTILITIES                |                  |        |            |
| EXIST. TO REMAIN                  | — (Red line) —   |        |            |
| NEW UTILITY LOCATION              | — (Red line) —   |        |            |
| EXIST. TO BE ABANDONED OR REMOVED | — (Green line) — |        |            |
| (R) REMOVE                        | (A) ABANDON      |        |            |

NOTE:  
LOCATION OF CITY OF CROSSVILLE  
WATER AND SEWER SERVICES AND  
WATER METERS TO BE VERIFIED  
PRIOR TO DEVELOPMENT OF  
CONSTRUCTION PLANS.




COORDINATE VALUES ARE NAD(83) 1995  
AND ARE DATUM ADJUSTED BY THE  
FACTOR 1.0001 & TIED TO THE TGRN.

STATE OF TENNESSEE  
DEPARTMENT OF TRANSPORTATION  
BUREAU OF PLANNING & DEVELOPMENT

UTILITY  
LAYOUT


STA. 21+160' TO STA. 21+520'  
S.R. 28 / U.S. 127

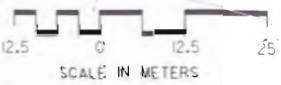



TENNESSEE D.O.T.  
DESIGN DIVISION  
FILE NO.

| TYPE   | YEAR | PROJECT NO.   | SHEET NO. |
|--------|------|---------------|-----------|
| R.O.W. | 2001 | 18006-2210-04 | U1-18     |
|        |      |               |           |
|        |      |               |           |

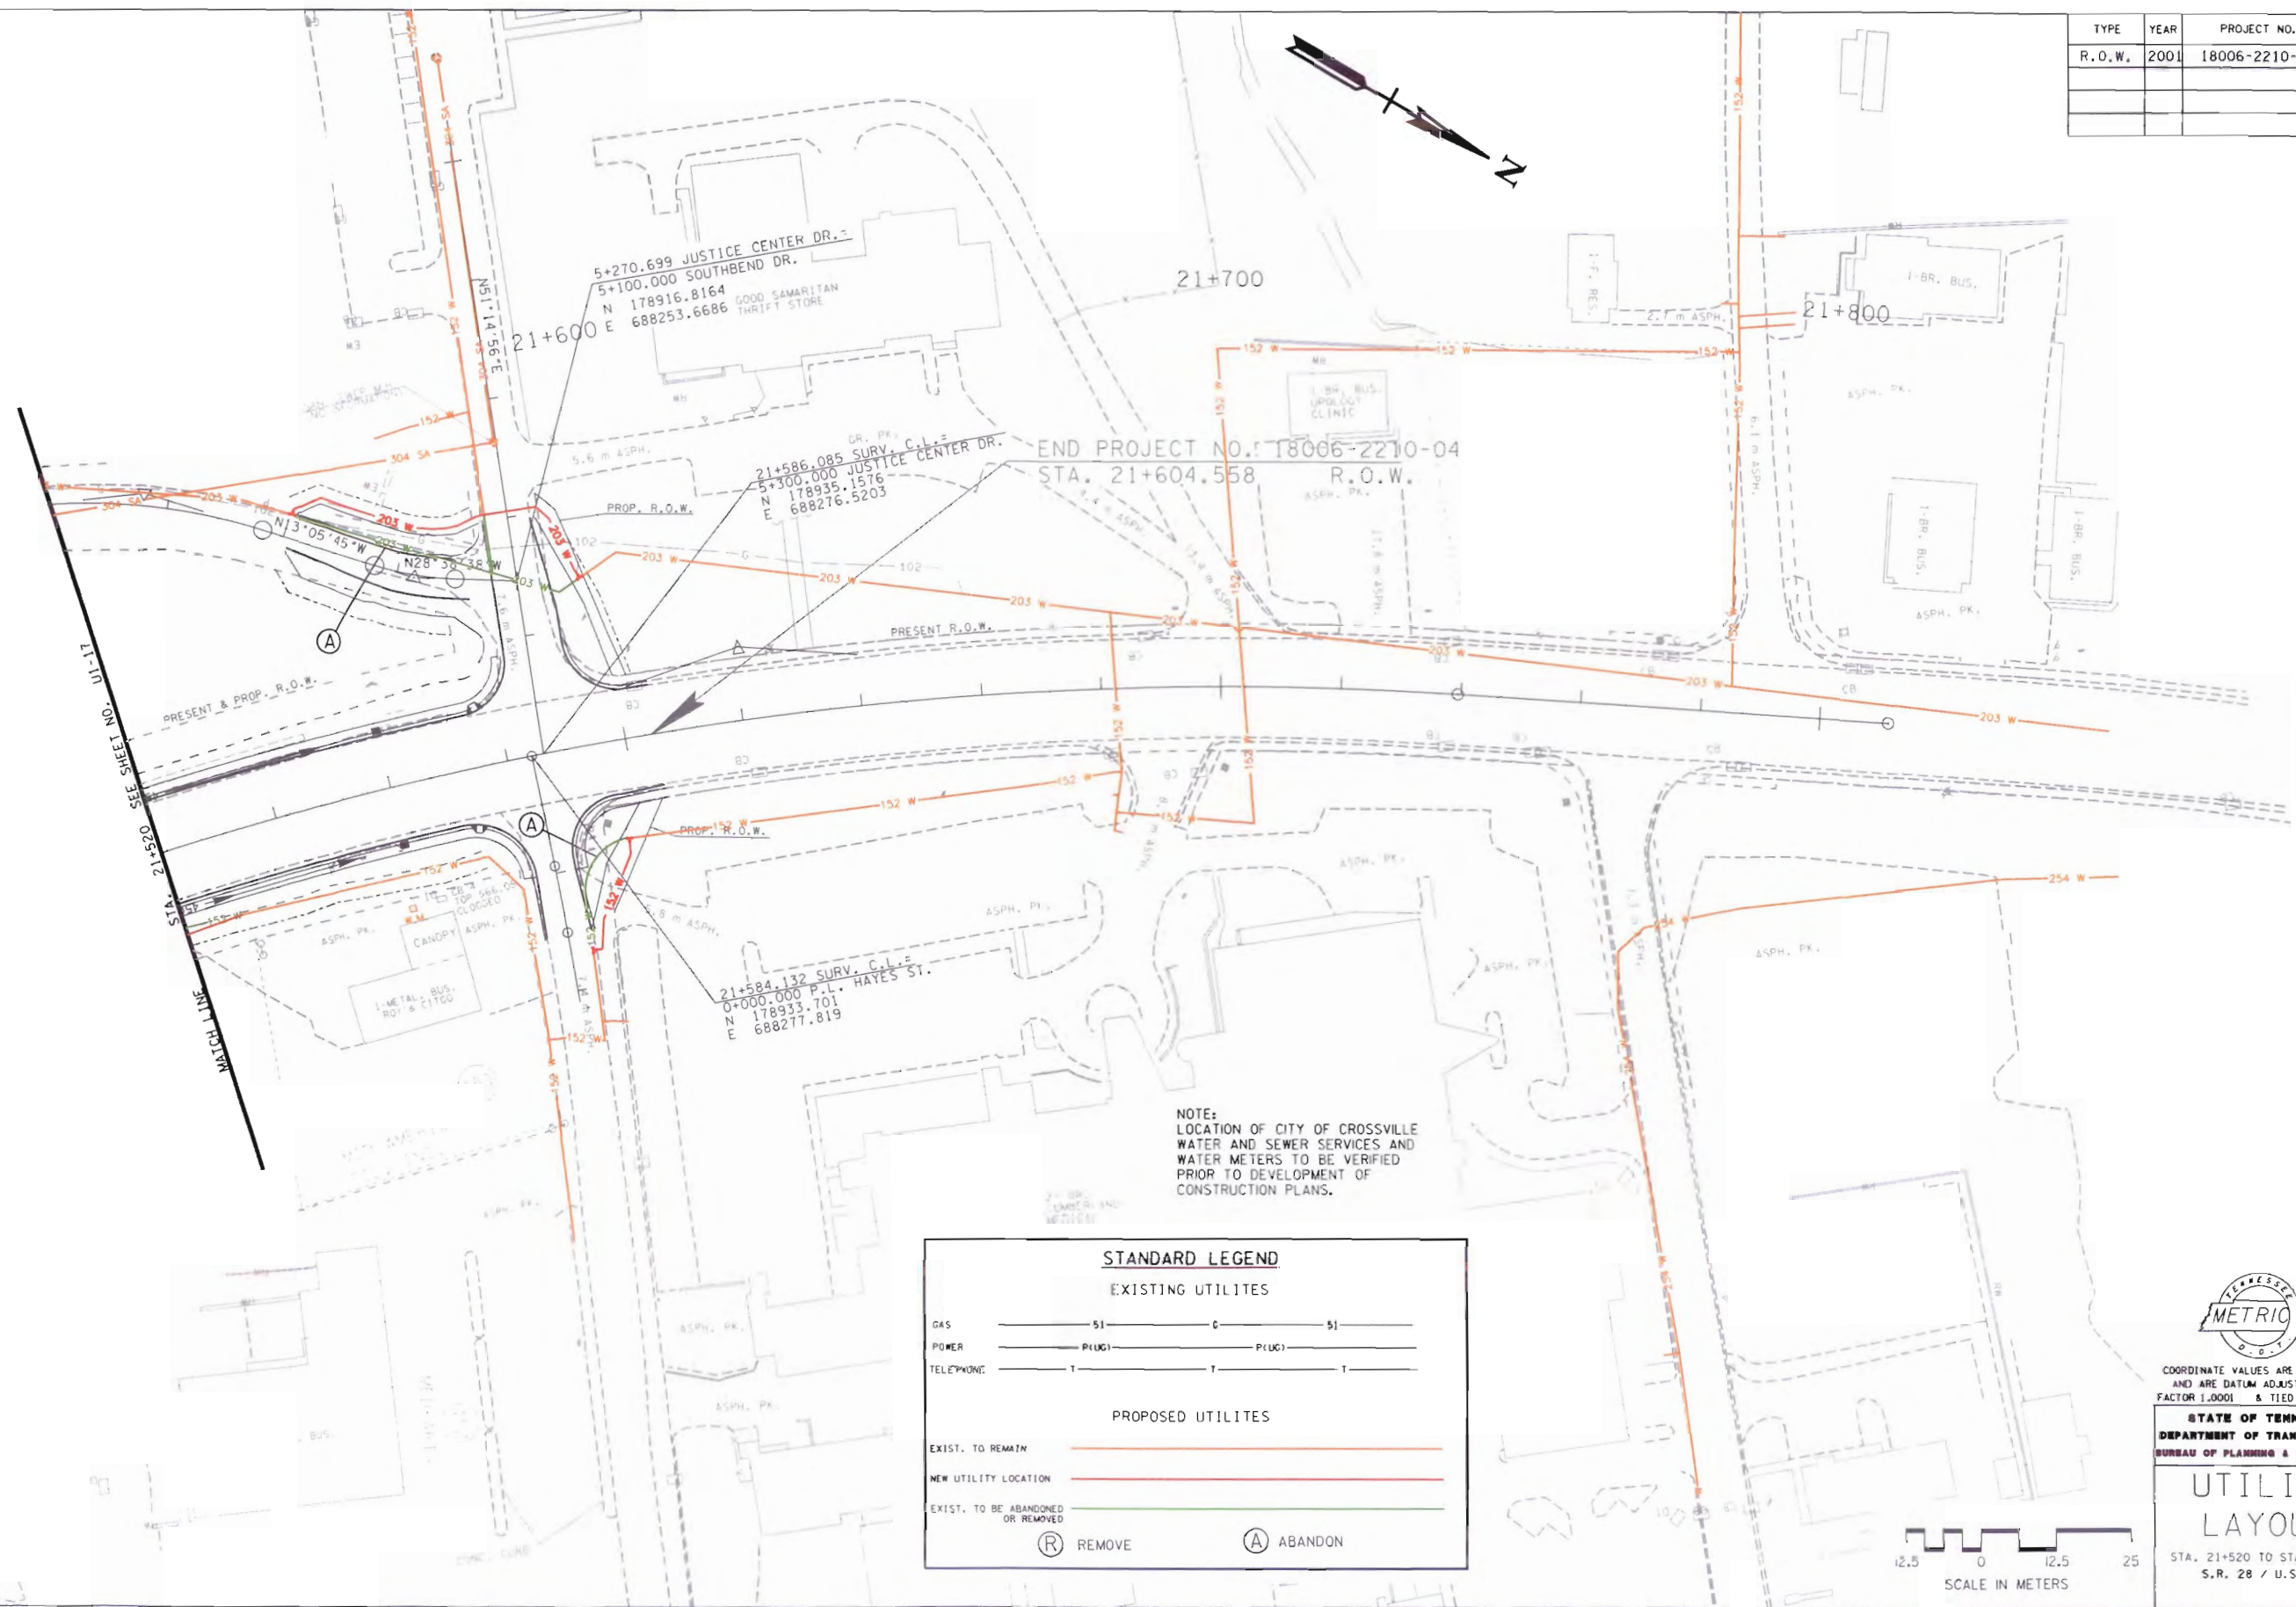

COORDINATE VALUES ARE NAD(83)1995  
AND ARE DATUM ADJUSTED BY THE  
FACTOR 1.0001 & TIED TO THE T.G.R.N.

STATE OF TENNESSEE  
DEPARTMENT OF TRANSPORTATION  
BUREAU OF PLANNING & DEVELOPMENT


# UTILITY LAYOUT

STA. 21+520 TO STA. 21+810  
S.R. 28 / U.S. 127



TENNESSEE D.O.T.  
DESIGN DIVISION  
FILE NO.

| TYPE   | YEAR | PROJECT NO.   | SHEET NO. |
|--------|------|---------------|-----------|
| R.O.W. | 2001 | 18006-2210-04 | U1-19     |
|        |      |               |           |
|        |      |               |           |

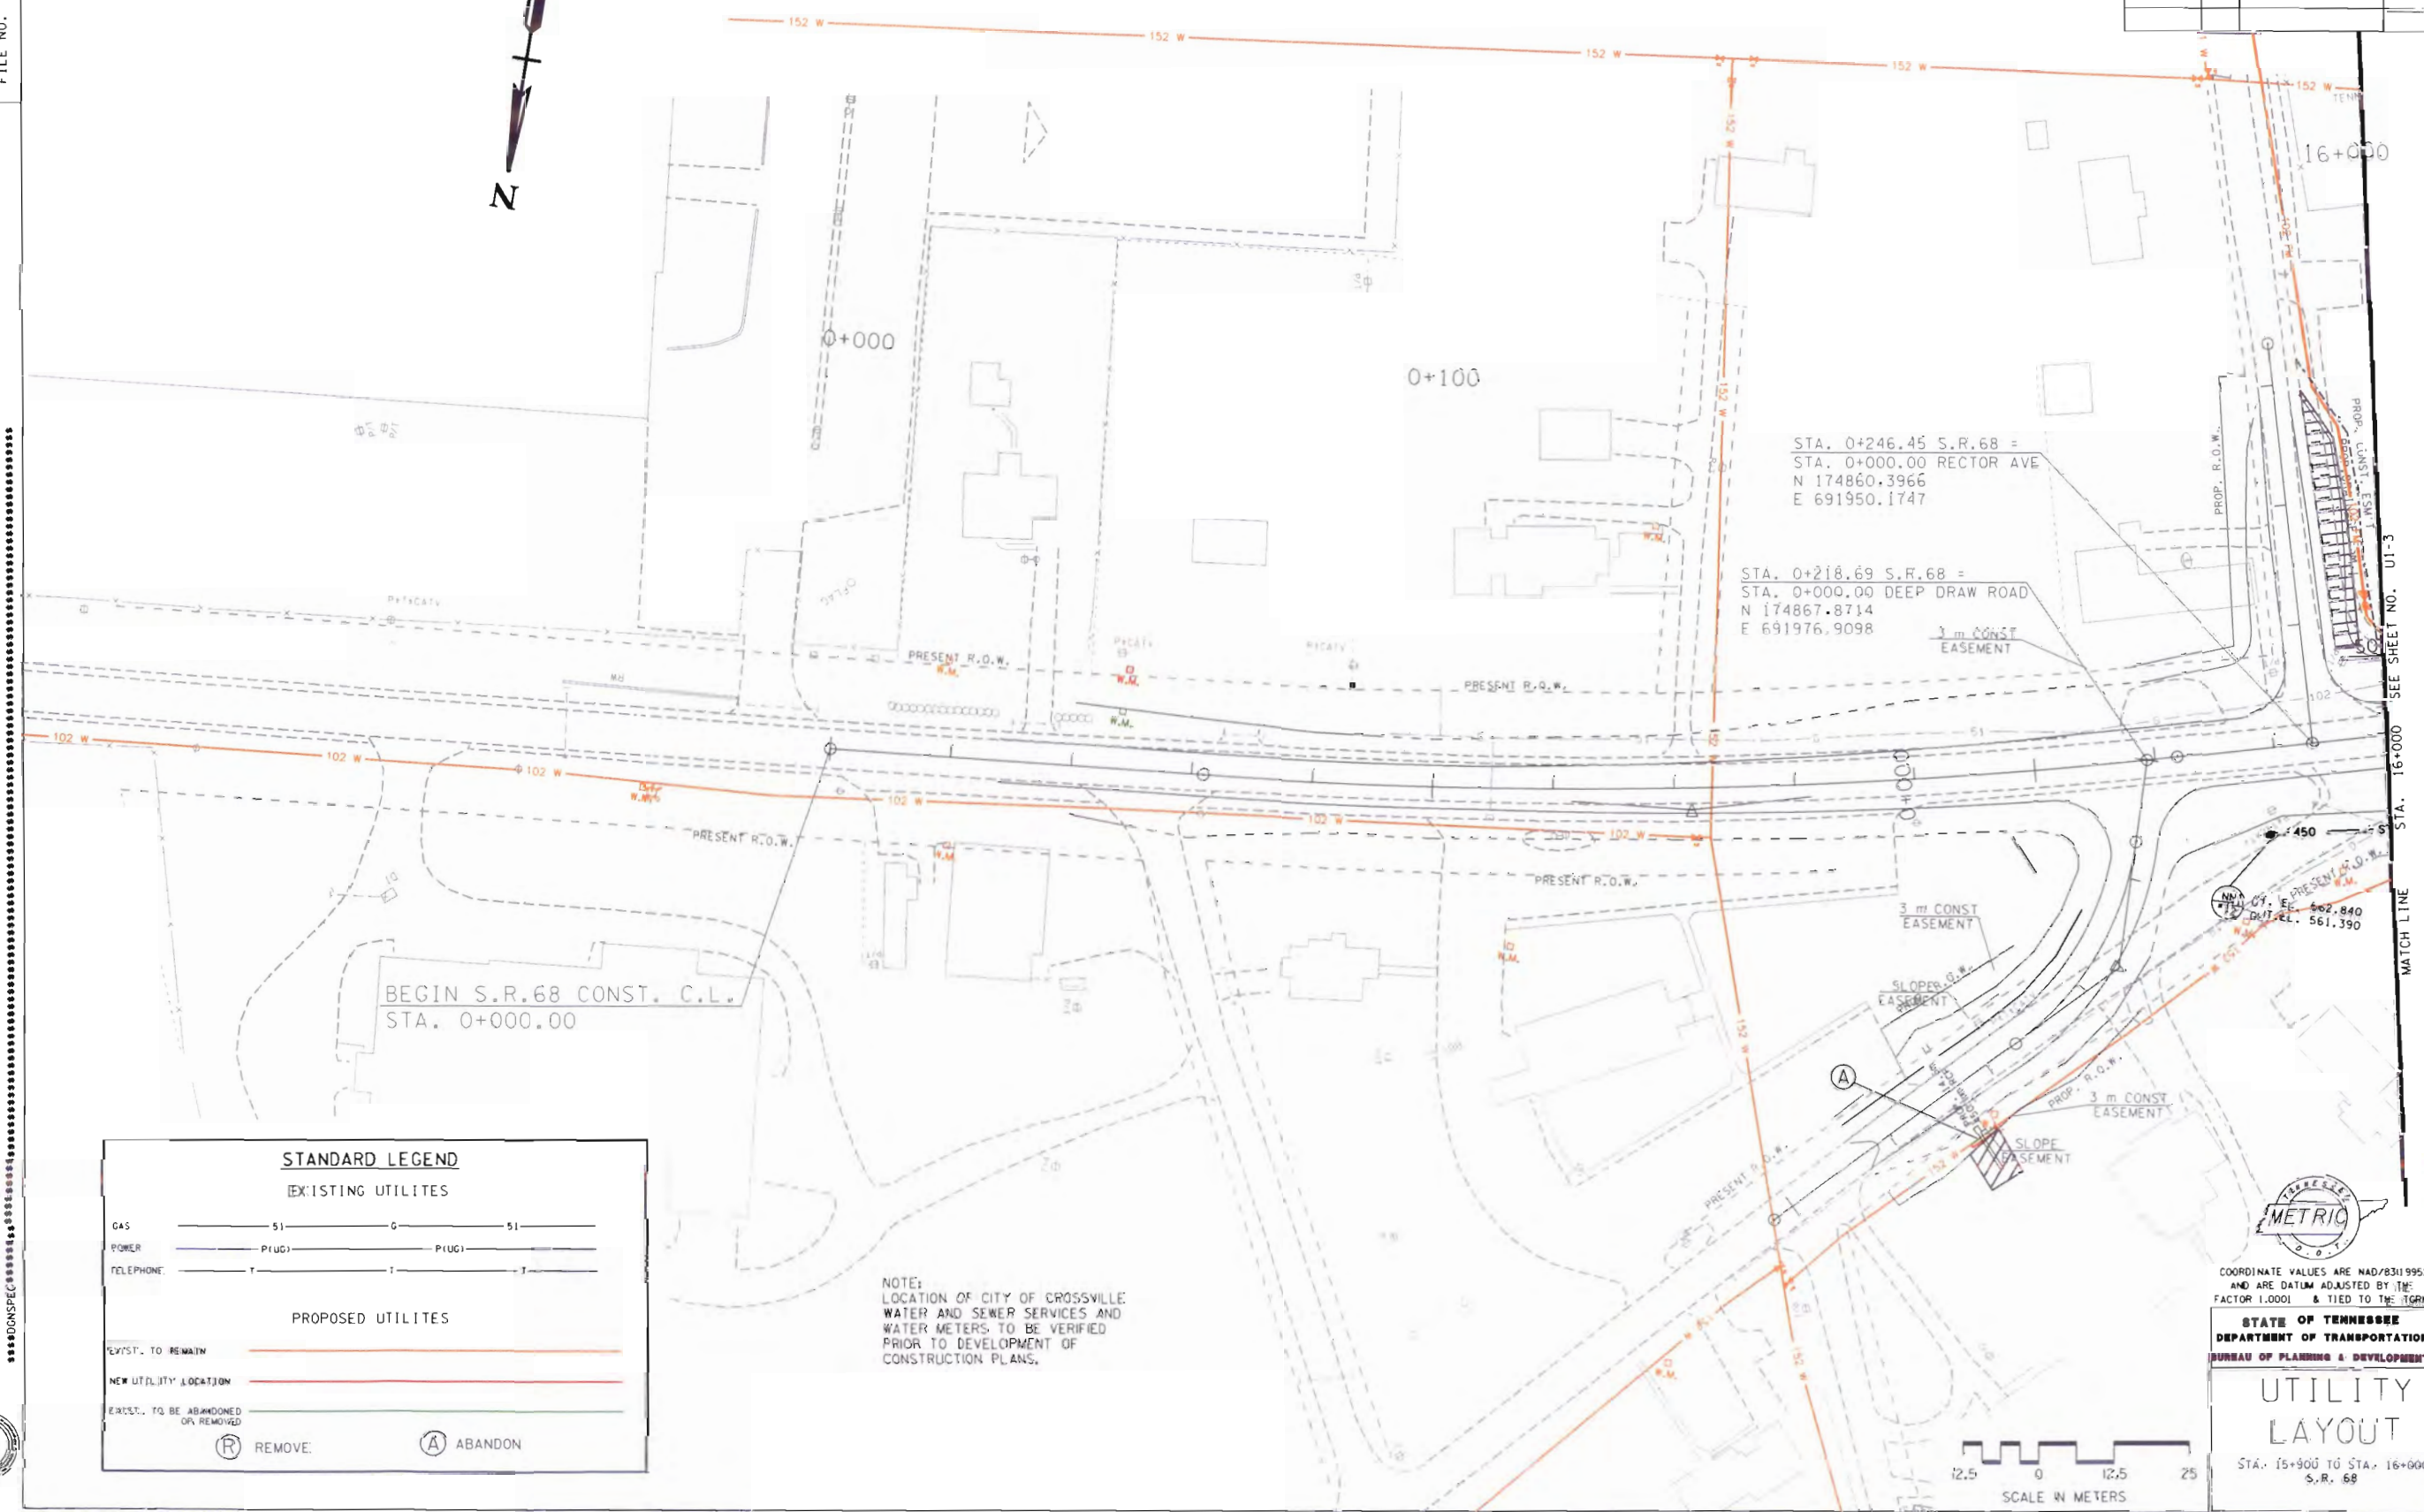

**STANDARD LEGEND**

**EXISTING UTILITIES**

GAS ——— S1 ——— G ——— S1 ———

POWER ——— P(UG) ——— P(UG) ———

TELEPHONE ——— T ——— T ——— T ———

**PROPOSED UTILITIES**

EXIST. TO REMAIN ———

NEW UTILITY LOCATION ———

EXIST. TO BE ABANDONED OR REMOVED ———

REMOVE: (R) ABANDON: (A)

NOTE:  
LOCATION OF CITY OF CROSSVILLE  
WATER AND SEWER SERVICES AND  
WATER METERS TO BE VERIFIED  
PRIOR TO DEVELOPMENT OF  
CONSTRUCTION PLANS.

STATE OF TENNESSEE  
DEPARTMENT OF TRANSPORTATION  
BUREAU OF PLANNING & DEVELOPMENT

**UTILITY LAYOUT**

STA. 15+900 TO STA. 16+000  
S.R. 68

COORDINATE VALUES ARE NAD(83)1995  
AND ARE DATUM ADJUSTED BY THE  
FACTOR 1.0001 & TIED TO THE TGRN.